

USE TYPEWRITER OR BALL POINT PEN-PRESS FIRMLY, PRINT CLEARLY.


WATER WELL RECORD  
KSA 82a-1201-1215

Kansas Department of Health and Environment-Division of Environment  
(Water well Contractors)  
Topeka, Kansas 66620

DDD

1. Location of well: County SHERMAN Fraction SE 1/4 SE 1/4 SE 1/4 Section number 4 Township number T 8 S R 42 NW

2. Distance and direction from nearest town or city: KANORADO  
Street address of well location if in city: 3 N NE  
3. Owner of well: John T Nelson  
R.R. or street: RR 2 Box 100  
City, state, zip code: KANORADO KANSAS 67741

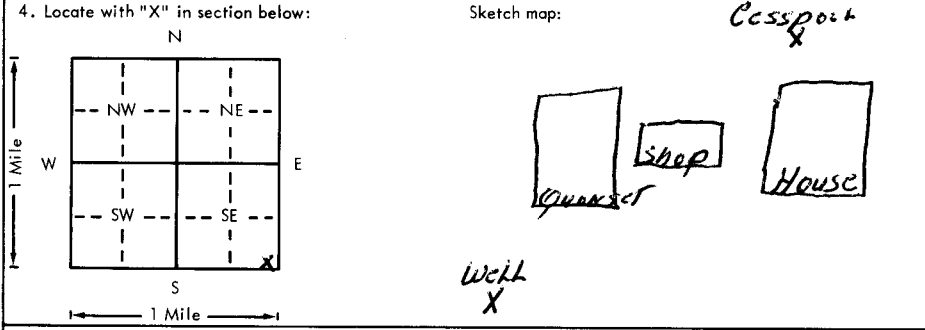

6. Bore hole dia. 8 in. Completion date 1-30-78  
Well depth 290 ft.  
7.  Cable tool  Rotary  Driven  Dug  
 Hollow rod  Jetted  Bored  Reverse rotary  
8. Use:  Domestic  Public supply  Industry  
 Irrigation  Air conditioning  Stock  
 Lawn  Oil field water  Other  
9. Casing: Material PLASTIC Height: Above or below  
Threaded  Welded  Surface 12 in.  
RMP  PVC  Weight        lbs./ft.  
Dia. 4 in. to 258 ft. depth Wall Thickness: inches or  
Dia.        in. to        ft. depth gage No. 237

5. Type and color of material	From	To
<u>TOP SOIL</u>	<u>0</u>	<u>4</u>
<u>CLAY</u>	<u>4</u>	<u>45</u>
<u>M GRAVEL, SANDY CLAY</u>	<u>45</u>	<u>169</u>
<u>SANDY CLAY, SANDSTONE</u>	<u>169</u>	<u>197</u>
<u>FINE SAND,</u>	<u>197</u>	<u>205</u>
<u>FINE SAND, SANDSTONE</u>	<u>205</u>	<u>240</u>
<u>FINE SAND, TRACE LOY</u>	<u>240</u>	<u>275</u>
<u>M GRAVEL</u>	<u>275</u>	<u>290</u>
<u>?</u>		

10. Screen: Manufacturer's name Peerless  
Type LAUREA Dia. 5  
Slot/gauze 1/8 x .258 Length 32  
Set between 258 ft. and 290 ft.  
       ft. and        ft.  
Gravel pack? YES Size range of material 1/8  
11. Static water level: 145 ft. below land surface Date 1-20-78 mo./day/yr.  
12. Pumping level below land surfaces:  
190 ft. after 3 hrs. pumping 20 g.p.m.  
       ft. after        hrs. pumping        g.p.m.  
Estimated maximum yield 50 g.p.m.  
13. Water sample submitted:        mo./day/yr.  
Yes  No  Date         
14. Well head completion:  
 Pitless adapter 12 Inches above grade  
15. Well grouted? YES  
With:  Neat cement  Bentonite  Concrete  
Depth: From 5 ft. to 15 ft.  
16. Nearest source of possible contamination: Cassport  
ft. 175 Direction NE Type pond  
Well disinfected upon completion?  Yes  No  
17. Pump:  Not installed  
Manufacturer's name Red Jacket  
Model number 14BC HP 1 Volts 230  
Length of drop pipe 200 ft. capacity 15 g.p.m.  
Type:  
 Submersible  Turbine  
 Jet  Reciprocating  
 Centrifugal  Other

18. Elevation: 381.4 (TOPO)  
19. Remarks: 381.4 (TOPO)  
Topography:  
 Hill  
 Slope  
 Upland  
 Valley

20. Water well contractor's certification:  
This well was drilled under my jurisdiction and this report is true to the best of my knowledge and belief.  
R & H Drilling Co Inc 166  
Business name License No.         
Address Goodland Kansas  
Signed Bill Clifford Date 1-30-78  
Authorized representative

T 8 420 Sec 4 SE SE SE 1/4 1/4 1/4