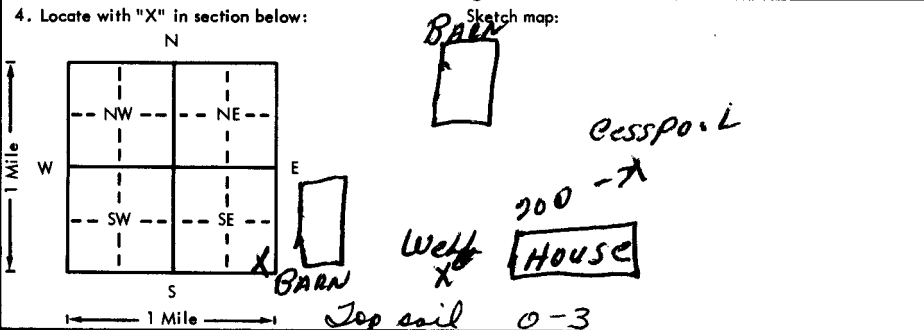


USE TYPEWRITER OR BALL POINT PEN-PRESS FIRMLY, PRINT CLEARLY.

WATER WELL RECORD
KSA 82a-1201-1215

Kansas Department of Health and Environment-Division of Environment
(Water well Contractors)
Topeka, Kansas 66620

DDI

1. Location of well:		County SHERMAN	Fraction SE 1/4 SE 1/4 SE 1/4	Section number 8	Township number T 8	Range number S R 42 1/4 W
2. Distance and direction from nearest town or city: KANORADO Street address of well location if in city: 1/2 E 2 N				3. Owner of well: COLETTA SOETTLNER R.R. or street: RR2 City, state, zip code: KANORADO KANSAS		
4. Locate with "X" in section below: Sketch map: 				6. Bore hole dia. 8 in. Completion date 8-1-76 Well depth 322 ft.		
5. Type and color of material				7. <input type="checkbox"/> Cable tool <input checked="" type="checkbox"/> Rotary <input type="checkbox"/> Driven <input type="checkbox"/> Dug <input type="checkbox"/> Hollow rod <input type="checkbox"/> Jetted <input type="checkbox"/> Bored <input type="checkbox"/> Reverse rotary		
8. Use: <input checked="" type="checkbox"/> Domestic <input type="checkbox"/> Public supply <input type="checkbox"/> Industry <input type="checkbox"/> Irrigation <input type="checkbox"/> Air conditioning <input type="checkbox"/> Stock <input type="checkbox"/> Lawn <input type="checkbox"/> Oil field water <input type="checkbox"/> Other				9. Casing: Material PLASTIC Height: Above or below Threaded <input type="checkbox"/> Welded <input checked="" type="checkbox"/> Surface 12 in. RMP <input type="checkbox"/> PVC <input checked="" type="checkbox"/> Weight _____ lbs./ft. Dia. 4 1/2 in. to 302 ft. depth Wall Thickness: inches or Dia. _____ in. to _____ ft. depth Gauge No. 200-237		
10. Screen: Manufacturer's name Jess + Lowell				11. Static water level: _____ mo./day/yr. 170 ft. below land surface Date 7-26-76		
11. M GRAVEL				12. Pumping level below land surfaces: 195 ft. after 3 hrs. pumping 20 g.p.m. _____ ft. after _____ hrs. pumping _____ g.p.m. Estimated maximum yield 30 g.p.m.		
12. M GRAVEL SANDY CLAY, SANDSTONE				13. Water sample submitted: _____ mo./day/yr. <input type="checkbox"/> Yes <input checked="" type="checkbox"/> No Date _____		
13. SANDY CLAY, SANDSTONE				14. Well head completion: <input checked="" type="checkbox"/> Pitless adapter 12 inches above grade		
14. FINE SAND, SANDSTONE				15. Well grouted? YES		
15. FINE SAND, CLAY, SANDSTONE				16. Nearest source of possible contamination: 200 ft. NE Direction NE Type POOL Well disinfected upon completion? <input checked="" type="checkbox"/> Yes <input type="checkbox"/> No		
16. FINE SAND, M GRAVEL				17. Pump: Not installed Manufacturer's name Reda Model number 120 HP 1 Volts 230 Length of drop pipe 214 ft. capacity 20 g.p.m. Type: <input checked="" type="checkbox"/> Submersible _____ Turbine <input type="checkbox"/> Jet _____ Reciprocating <input type="checkbox"/> Centrifugal _____ Other		
17. SANDY CLAY, SANDSTONE				18. Elevation:		
18. M GRAVEL				19. Remarks:		
19. M GRAVEL				20. Water well contractor's certification: This well was drilled under my jurisdiction and this report is true to the best of my knowledge and belief. St H Drilling Co 166 Business name _____ License No. _____ Address Woodland Kansas Signed Bill Clifford Date _____ Authorized representative 8-2-76		
20. Ochre				Topography: <input type="checkbox"/> Hill <input type="checkbox"/> Slope <input checked="" type="checkbox"/> Upland <input type="checkbox"/> Valley		
21. BROOK 320						

T 8
 R 42
 W 1/4
 E 1/4
 S 1/4
 SE 1/4
 SE 1/4
 SE 1/4