


1 LOCATION OF WATER WELL: Fraction SW 1/4 SE 1/4 SW 1/4 Section Number 20 Township Number T 8 S Range Number R 22 E

County: Sherman Distance and direction from nearest town or city street address of well if located within city?

2 WATER WELL OWNER: Sina Gamboa  
 RR#, St. Address, Box #: 310 Locust Board of Agriculture, Division of Water Resources  
 City, State, ZIP Code: Baronado, KS 67741 Application Number:

3 LOCATE WELL'S LOCATION WITH AN "X" IN SECTION BOX:

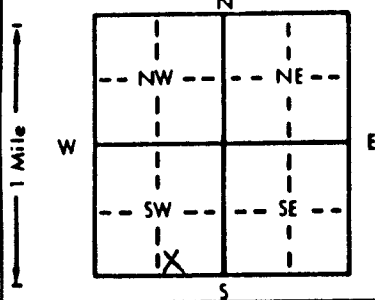

4 DEPTH OF COMPLETED WELL: 100 ft. ft. ELEVATION:

Depth(s) Groundwater Encountered 1. .... ft. 2. .... ft. 3. .... ft.

WELL'S STATIC WATER LEVEL dry ft. below land surface measured on mo/day/yr

Pump test data: Well water was .... ft. after .... hours pumping .... gpm

Est. Yield .... gpm: Well water was .... ft. after .... hours pumping .... gpm

Bore Hole Diameter .... in. to .... ft., and .... in. to .... ft.

WELL WATER TO BE USED AS:  
 Domestic     3 Feedlot     6 Oil field water supply     8 Air conditioning     11 Injection well  
 2 Irrigation     4 Industrial     7 Lawn and garden only     9 Dewatering     12 Other (Specify below)

Was a chemical/bacteriological sample submitted to Department? Yes.....No.....; If yes, mo/day/yr sample was submitted

5 TYPE OF BLANK CASING USED:  
 1 Steel     3 RMP (SR)     5 Wrought iron     8 Concrete tile    CASING JOINTS:  Glued     Clamped  
 2 PVC     4 ABS     6 Asbestos-Cement     9 Other (specify below)     Welded  
 7 Fiberglass     Threaded

Blank casing diameter 5 in. to .... ft., Dia. .... in. to .... ft., Dia. .... in. to .... ft.

Casing height above land surface .... in., weight .... lbs./ft. Wall thickness or gauge No. ....

TYPE OF SCREEN OR PERFORATION MATERIAL:  
 1 Steel     3 Stainless steel     5 Fiberglass     7 PVC     10 Asbestos-cement  
 2 Brass     4 Galvanized steel     6 Concrete tile     8 RMP (SR)     11 Other (specify) .....

SCREEN OR PERFORATION OPENINGS ARE:  
 1 Continuous slot     3 Mill slot     5 Gauzed wrapped     8 Saw cut     11 None (open hole)  
 2 Louvered shutter     4 Key punched     6 Wire wrapped     9 Drilled holes

SCREEN-PERFORATED INTERVALS: From .... ft. to .... ft., From .... ft. to .... ft.

GRAVEL PACK INTERVALS: From .... ft. to .... ft., From .... ft. to .... ft.

6 GROUT MATERIAL:  1 Neat cement     2 Cement grout     3 Bentonite     4 Other .....

Grout intervals: From 4 ft. to 2 ft., From .... ft. to .... ft., From .... ft. to .... ft.

What is the nearest source of possible contamination:  
 1 Septic tank     4 Lateral lines     7 Pit privy     10 Livestock pens     14 Abandoned water well  
 2 Sewer lines     5 Cess pool     8 Sewage lagoon     11 Fuel storage     15 Oil well/Gas well  
 3 Watertight sewer lines     6 Seepage pit     9 Feedyard     12 Fertilizer storage     16 Other (specify below) none  
 13 Insecticide storage

Direction from well? How many feet?

FROM	TO	LITHOLOGIC LOG	FROM	TO	PLUGGING INTERVALS
					removed 3ft casing
			10	4	sand
			4	2	bentonite chips
			2	0	sand

**RECEIVED**

DEC 04 1991

DIVISION OF ENVIRONMENT

7 CONTRACTOR'S OR LANDOWNER'S CERTIFICATION: This water well was (1) constructed, (2) reconstructed, or (3) plugged under my jurisdiction and was completed on (mo/day/year) 10-25-91 and this record is true to the best of my knowledge and belief. Kansas

Water Well Contractor's License No. .... This Water Well Record was completed on (mo/day/yr) 12-3-91

under the business name of ..... by (signature) Paul Davis  
GMO 4

OFFICE USE ONLY

T

R

EW

SEC.

1/4

1/4

1/4