


1 LOCATION OF WATER WELL: Fraction NW 1/4 NW 1/4 NW 1/4 Section Number 33 Township Number T 8 S Range Number R 42 E
 County: STERMAN

Distance and direction from nearest town or city street address of well if located within city?
1/2 East, 1/2 South, Kanorado, KS. Ph. 913,397-2283

2 WATER WELL OWNER: George Schmidt
 RR#, St. Address, Box #: Box # 155 Board of Agriculture, Division of Water Resources
 City, State, ZIP Code: Kanorado, Kansas 67741 Application Number:

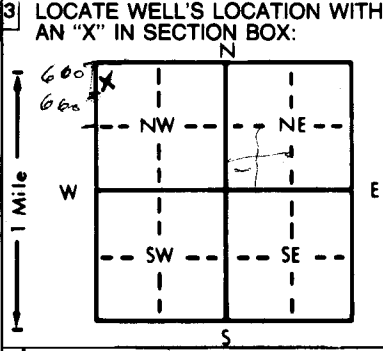

4 DEPTH OF COMPLETED WELL: 180 ft. ELEVATION: —
 Depth(s) Groundwater Encountered: 1. — ft. 2. — ft. 3. — ft.
 WELL'S STATIC WATER LEVEL: 87' ft. below land surface measured on mo/day/yr 5-23-88
 Pump test data: Well water was — ft. after — hours pumping — gpm
 Est. Yield — gpm: Well water was — ft. after — hours pumping — gpm
 Bore Hole Diameter: 8 in. to 24 ft., and 6" in. to 180' ft.
 WELL WATER TO BE USED AS:
 1 Domestic 3 Feedlot 6 Oil field water supply 9 Dewatering 12 Other (Specify below)
 2 Irrigation 4 Industrial 7 Lawn and garden only 10 Observation well
 Was a chemical/bacteriological sample submitted to Department? Yes No; If yes, mo/day/yr sample was submitted
 Water Well Disinfected? Yes No

5 TYPE OF BLANK CASING USED:
 1 Steel 3 RMP (SR) 5 Wrought iron 8 Concrete tile CASING JOINTS: Glued Clamped
 2 PVC 4 ABS 6 Asbestos-Cement 9 Other (specify below) Welded
 7 Fiberglass Threaded
 Blank casing diameter: 4 1/2 in. to 160 ft., Dia. in. to — ft., Dia. in. to — ft.
 Casing height above land surface: 1 in., weight 160# PVC lbs./ft. Wall thickness or gauge No. —
 TYPE OF SCREEN OR PERFORATION MATERIAL:
 1 Steel 3 Stainless steel 5 Fiberglass 7 PVC 10 Asbestos-cement
 2 Brass 4 Galvanized steel 6 Concrete tile 8 RMP (SR) 11 Other (specify) T.I.A.M. 030
 12 None used (open hole)
 SCREEN OR PERFORATION OPENINGS ARE:
 1 Continuous slot 3 Mill slot 5 Gauzed wrapped 8 Saw cut 11 None (open hole)
 2 Louvered shutter 4 Key punched 6 Wire wrapped 9 Drilled holes
 7 Torch cut 10 Other (specify) —
 SCREEN-PERFORATED INTERVALS: From 160 ft. to 180 ft., From — ft. to — ft.
 From — ft. to — ft., From — ft. to — ft.
 GRAVEL PACK INTERVALS: From 80 ft. to 180 ft., From — ft. to — ft.
 From — ft. to — ft., From — ft. to — ft.

6 GROUT MATERIAL: 1 Neat cement 2 Cement grout 3 Bentonite 4 Other
 Grout Intervals: From 5' ft. to 24' ft., From — ft. to — ft., From — ft. to — ft.
 What is the nearest source of possible contamination: None within 1/2 mile
 1 Septic tank 4 Lateral lines Pit privy Livestock pens 14 Abandoned water well
 2 Sewer lines 5 Cess pool 8 Sewage lagoon 11 Fuel storage 15 Oil well/Gas well
 3 Watertight sewer lines 6 Seepage pit 9 Feedyard 12 Fertilizer storage 16 Other (specify below)
 13 Insecticide storage

Direction from well? How many feet?

FROM	TO	LITHOLOGIC LOG	FROM	TO	LITHOLOGIC LOG
0	40	SANDY clay			
40	80	SAND + clay LAYERED			
80	120	SAND + clay			
120	140	clay			
140	175	COARSE SAND + GRAVEL			
175	180	Shale			

7 CONTRACTOR'S OR LANDOWNER'S CERTIFICATION: This water well was (1) constructed, (2) reconstructed, or (3) plugged under my jurisdiction and was completed on (mo/day/year) 5-23-88 and this record is true to the best of my knowledge and belief. Kansas
 Water Well Contractor's License No. 488 This Water Well Record was completed on (mo/day/yr) 5-23-88
 under the business name of SCHAFF Drilling Co. by (signature) Ruben Schaff