


WATER WELL RECORD Form WWC-5 KSA 82a-1212

1 LOCATION OF WATER WELL: Fraction SW 1/4 SW 1/4 NW 1/4 Section Number 13 Township Number T 8 S Range Number R 5 E

Distance and direction from nearest town or city street address of well if located within city? Inside City limits

2 WATER WELL OWNER: Danny Henk RR#, St. Address, Box #: 405 E 2nd City, State, ZIP Code: Glassboro, Kansas Board of Agriculture, Division of Water Resources Application Number:

3 LOCATE WELL'S LOCATION WITH AN "X" IN SECTION BOX: [Section Box Diagram]

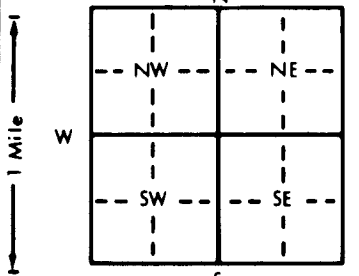

4 DEPTH OF COMPLETED WELL: 35' ft. ELEVATION: 18' 18" ft. below land surface measured on mo/day/yr 5-3-93

WELL'S STATIC WATER LEVEL: 18' 18" ft. below land surface measured on mo/day/yr 5-3-93 Pump test data: Well water was ... ft. after ... hours pumping ... gpm Est. Yield: 30 gpm

5 TYPE OF BLANK CASING USED: 2 PVC Blank casing diameter: 5" in. to 25" ft. Dia. Casing height above land surface: 15" in. weight ... lbs./ft. Wall thickness or gauge No. 25

TYPE OF SCREEN OR PERFORATION MATERIAL: 7 PVC 10 Asbestos-cement 11 Other (specify) 12 None used (open hole)

SCREEN OR PERFORATION OPENINGS ARE: 8 Saw cut 11 None (open hole) 1 Continuous slot 3 Mill slot 6 Wire wrapped 9 Drilled holes 2 Louvered shutter 4 Key punched 7 Torch cut 10 Other (specify)

SCREEN-PERFORATED INTERVALS: From 25' ft. to 35' ft. GRAVEL PACK INTERVALS: From 18' ft. to 35' ft.

6 GROUT MATERIAL: 3 Bentonite Grout intervals: From 0 ft. to 18' ft.

What is the nearest source of possible contamination: 10 Livestock pens 14 Abandoned water well 1 Septic tank 4 Lateral lines 7 Pit privy 11 Fuel storage 15 Oil well/Gas well 2 Sewer lines 5 Cess pool 8 Sewage lagoon 12 Fertilizer storage 16 Other (specify below) 3 Watertight sewer lines 6 Seepage pit 9 Feedyard 13 Insecticide storage N/A

Direction from well? How many feet?

FROM	TO	LITHOLOGIC LOG	FROM	TO	PLUGGING INTERVALS
0	4	Topsoil			
4	11	clay			
11	18	sand + clay			
18	35	sand + gravel			
35		clay.			

7 CONTRACTOR'S OR LANDOWNER'S CERTIFICATION: This water well was (1) constructed, (2) reconstructed, or (3) plugged under my jurisdiction and was completed on (mo/day/year) 5-3-93 and this record is true to the best of my knowledge and belief. Kansas Water Well Contractor's License No. 361 This Water Well Record was completed on (mo/day/yr) 6-10-93 under the business name of Cox-BESWICK FRRIG. SERV. by signature: Cecil Beswick

INSTRUCTIONS: Use typewriter or ball point pen. PLEASE PRESS FIRMLY and PRINT clearly. Please fill in blanks, underline or circle the correct answers. Send top three copies to Kansas Department of Health and Environment, Bureau of Water, Topeka, Kansas 66620-0001. Telephone: 913-296-5545. Send one to WATER WELL OWNER and retain one for your records.