USE TYPEWRITER OR BALL POINT PEN-PRESS FIRMLY, PRINT CLEARLY.

T R EW sec 1/4 1/4 1/4 No.

WATER WELL RECORD
KSA 82a-1201-1215

Kansas State Dept. Of Health
(Water Well Contractors)
Forbes-Bldg. 740
Topeka, Kansas 66620

1 Location of well:	County	Township name	Fraction	Section number	Town number	Range number
	MITCHELL	LOGAN	CS½ SW¼ NE¼	36	T 8 ~~S~~	R 6 ~~W~~

Distance and direction from nearest town or city: 4 SOUTH ½ WEST OF SIMPSON

Street address of well location if in city:

3 Owner of well: LA VOLA B. + RUTH E. KRENKEL

Address: 10903 BRISTOL TERRACE K.C., MO. 64134

Locate with "X" in section below:

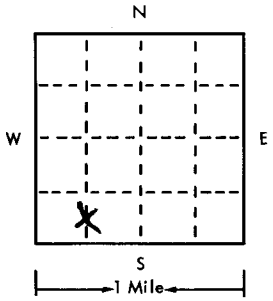

Sketch map:

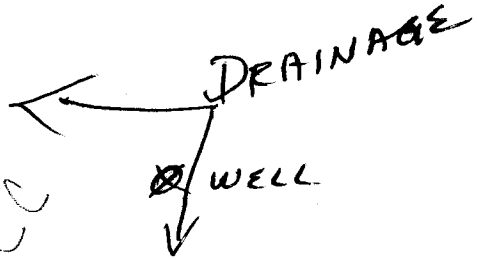

4 Well depth: 160 ft. Date of completion 11/13/75
Well diameter 8 in.

5 ☐ Coble tool ☒ Rotary ☐ Driven ☐ Dug ☐ Hollow rod ☐ Jetted ☐ Bored ☐ Reverse rotary

6 Use: ☒ Domestic ☐ Public supply ☐ Industry ☐ Irrigation ☐ Air conditioning ☐ Commercial ☐ Test well ☐

7 Casing: Material PVC Height: above/below
Threaded ☐ Welded ☒ Surface 12 in.
Diam. Weight 3 lbs./ft.
5 in. to 160 ft. depth Drive shoe? ☐ Yes ☒ No
in. to ft. depth

2 Type and color of material	From	To
TOPSOIL	0	1
LIMESTONE	1	4
GRAY CLAY W/LIMESTONE	4	19
GRAY SHALE	19	132
SHALE W/ROCK LAYERS	132	139
RED SHALE	139	152
SANDROCK	152	160
RED SHALE	160	163
STOP	163	

(use a second sheet if needed)

8 Screen:
Manufacturer CERTAINTEED
Type PVC Dia. 5
Slot/gauze 40" Length 40'
Set between 120 ft. and 160 ft. 120-160
Fittings:
Gravel pack ☒ Yes ☐ No Size range of material 1/8 x 1/4"

9 Static water level:
100 ft. below land surface Date 11/13/75

10 Pumping level below land surfaces:
ft. after N/A hrs. pumping g.p.m.
ft. after N/A hrs. pumping g.p.m.
Estimated maximum yield 4 g.p.m.

11 Water sample submitted:
☐ Yes ☒ No Date

12 Well head completion:
☐ Pitless adapter ☒ Inches above grade

13 Well grouted? ☒ Yes ☐ No
☒ Neat cement ☐ Bentonite ☐
Depth: From 0 ft. to 10 ft.

14 Nearest source of possible contamination:
ft. N/A Direction Type
Well disinfected upon completion? ☒ Yes ☐ No

15 Pump: ☒ Not installed
Manufacturer's name
Model number HP Volts
Length of drop pipe ft. capacity g.m.p.
Type:
☐ Submersible ☐ Turbine
☐ Jet ☐ Reciprocating
☐ Certrifugal ☐ Other

16 Remarks: elevation PASTURE WELL ON HILLY GROUND WITH GOOD DRAINAGE

Topography:
☒ Hill
☐ Slope
☐ Upland
☐ Valley

17 Water well contractor's certification:
This well was drilled under my jurisdiction and this report is true to the best of my knowledge and belief.
GEO COX + SONS INC 358
Business name License No.
Address CLIFTON, KANSAS
Signed Daryl Cox Date 11/13/75
Authorized representative

8 6E 36 CS½ SW NE

Forward the white, blue and pink copies to the Kansas State Dept. Of Health.

Form WWC-5

677-H