


1 LOCATION OF WATER WELL: County: Ottawa Fraction: SE 1/4 SW 1/4 SE 1/4 Section Number: 21 Township Number: T 9 S Range Number: R 1 E

Distance and direction from nearest town or city street address of well if located within city?  
FROM Oak Hill go 4 miles west on Backtop Road.

2 WATER WELL OWNER: Briant Terri Haley  
 RR#, St. Address, Box #: RR1 North 370th Rd  
 City, State, ZIP Code: Oak Hill, Kansas 67432  
 Board of Agriculture, Division of Water Resources  
 Application Number:

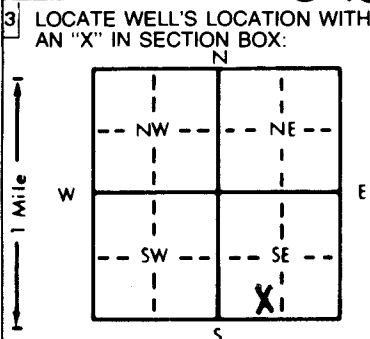

4 DEPTH OF COMPLETED WELL: 130' ft. ELEVATION:  
 Depth(s) Groundwater Encountered 1. 92' ft. 2. ft. 3. ft.  
 WELL'S STATIC WATER LEVEL: 80' ft. below land surface measured on mo/day/yr  
 Pump test data: Well water was ft. after hours pumping gpm  
 Est. Yield 15 gpm: Well water was ft. after hours pumping gpm  
 Bore Hole Diameter: 9 in. to 120 in. to in. to ft.  
 WELL WATER TO BE USED AS:  
 Domestic  Feedlot  Oil field water supply  Dewatering  Other (Specify below)  
 Irrigation  Industrial  Lawn and garden only  Monitoring well  
 Was a chemical/bacteriological sample submitted to Department? Yes No If yes, mo/day/yr sample was submitted  
 Water Well Disinfected:  Yes  No

5 TYPE OF BLANK CASING USED:  
 1 Steel  2 PVC  3 RMP (SR)  4 ABS  5 Wrought iron  6 Asbestos-Cement  7 Fiberglass  8 Concrete tile  9 Other (specify below)  
 Blank casing diameter: 5 in. to 100 ft., Dia. in. to ft., Dia. in. to ft.  
 Casing height above land surface: 2' in., weight Sch 40 lbs./ft. Wall thickness or gauge No.  
 TYPE OF SCREEN OR PERFORATION MATERIAL:  
 1 Steel  2 Brass  3 Stainless steel  4 Galvanized steel  5 Fiberglass  6 Concrete tile  7 PVC  8 RMP (SR)  9 ABS  10 Asbestos-cement  11 Other (specify)  12 None used (open hole)  
 SCREEN OR PERFORATION OPENINGS ARE:  
 1 Continuous slot  2 Louvered shutter  3 Mill slot  4 Key punched  5 Gauzed wrapped  6 Wire wrapped  7 Torch cut  8 Saw cut  9 Drilled holes  10 Other (specify)  11 None (open hole)  
 SCREEN-PERFORATED INTERVALS: From 100 ft. to 120 ft. From ft. to ft. From ft. to ft.  
 GRAVEL PACK INTERVALS: From 25 ft. to 120 ft. From ft. to ft. From ft. to ft.

6 GROUT MATERIAL: 1 Neat cement  2 Cement grout  3 Bentonite  4 Other   
 Grout Intervals: From 5 ft. to 25 ft. From ft. to ft. From ft. to ft.  
 What is the nearest source of possible contamination:  
 1 Septic tank  2 Sewer lines  3 Watertight sewer lines  4 Lateral lines  5 Cess pool  6 Seepage pit  7 Pit privy  8 Sewage lagoon  9 Feedyard  10 Livestock pens  11 Fuel storage  12 Fertilizer storage  13 Insecticide storage  14 Abandoned water well  15 Oil well/Gas well  16 Other (specify below)   
 Direction from well? South How many feet? 200

| FROM | TO  | LITHOLOGIC LOG     | FROM | TO | PLUGGING INTERVALS |
|------|-----|--------------------|------|----|--------------------|
| 0    | 1   | Top Soil           |      |    |                    |
| 1    | 10  | Brown Clay         |      |    |                    |
| 10   | 15  | Reddish Brown Clay |      |    |                    |
| 15   | 39  | Brown Shale        |      |    |                    |
| 39   | 51  | Greenish Shale     |      |    |                    |
| 51   | 59  | Sand Stone         |      |    |                    |
| 59   | 92  | Gray Shale         |      |    |                    |
| 92   | 120 | Sand Stone         |      |    |                    |

7 CONTRACTOR'S OR LANDOWNER'S CERTIFICATION: This water well was (1) constructed, (2) reconstructed, or (3) plugged under my jurisdiction and was completed on (mo/day/year) 5/15/98 and this record is true to the best of my knowledge and belief. Kansas Water Well Contractor's License No. 451 This Water Well Record was completed on (mo/day/yr) 6/25/98 under the business name of Haldeman Well Drilling by (signature) Craig Culp PE

OFFICE USE ONLY  
T  
R  
E  
M  
S  
E  
C.