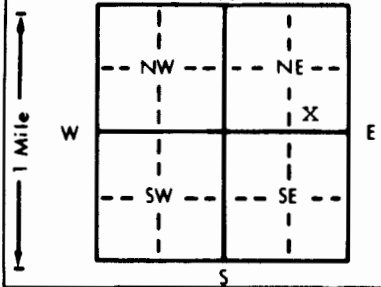


1 LOCATION OF WATER WELL: County: Osborne	Fraction SW 1/4 SE 1/4 NE 1/4	Section Number 18	Township Number T 9 S	Range Number R 13 EW
--	----------------------------------	----------------------	--------------------------	--------------------------------

Distance and direction from nearest town or city street address of well if located within city?
1/2 mile south of Covert, Kansas

2 WATER WELL OWNER: Seiple-Yarnell Agency
RR#, St. Address, Box # : c/o United Missouri Bank Box 713 Board of Agriculture, Division of Water Resources
City, State, ZIP Code : Russell, Kansas 67665 Application Number:

3 LOCATE WELL'S LOCATION WITH AN "X" IN SECTION BOX: 	4 DEPTH OF COMPLETED WELL: 40 ft. ELEVATION: Valley
	Depth(s) Groundwater Encountered 1. 25 ft. 2. . ft. 3. . ft. WELL'S STATIC WATER LEVEL 15 ft. below land surface measured on mo/day/yr 12/15/95 Pump test data: Well water was 15 ft. after 1 hours pumping 8 gpm Est. Yield 8 gpm: Well water was . ft. after . hours pumping gpm Bore Hole Diameter 10 in. to 40 ft., and . in. to . ft. WELL WATER TO BE USED AS: 1 5 Public water supply 8 Air conditioning 11 Injection well 1 Domestic 3 Feedlot 6 Oil field water supply 9 Dewatering 12 Other (Specify below) 2 Irrigation 4 Industrial 7 Lawn and garden only 10 Monitoring well Was a chemical/bacteriological sample submitted to Department? Yes . No X .; If yes, mo/day/yr sample was submitted Water Well Disinfected? Yes X No

5 TYPE OF BLANK CASING USED: 2 5 Wrought iron 8 Concrete tile CASING JOINTS: Glued **X** Clamped .
 1 Steel 3 RMP (SR) 6 Asbestos-Cement 9 Other (specify below) Welded .
 2 PVC 4 ABS 7 Fiberglass Threaded .
 Blank casing diameter 5 in. to 20 ft., Dia in. to . ft., Dia in. to . ft.
 Casing height above land surface 24 in., weight 2.29 lbs./ft. Wall thickness or gauge No. .26
 TYPE OF SCREEN OR PERFORATION MATERIAL: 7 7 PVC 10 Asbestos-cement
 1 Steel 3 Stainless steel 5 Fiberglass 8 RMP (SR) 11 Other (specify) .
 2 Brass 4 Galvanized steel 6 Concrete tile 9 ABS 12 None used (open hole)
 SCREEN OR PERFORATION OPENINGS ARE: 8 5 Gauzed wrapped 8 Saw cut 11 None (open hole)
 1 Continuous slot 3 Mill slot 6 Wire wrapped 9 Drilled holes
 2 Louvered shutter 4 Key punched 7 Torch cut 10 Other (specify) .
 SCREEN-PERFORATED INTERVALS: From 40 ft. to 20 ft., From . ft. to . ft.
 GRAVEL PACK INTERVALS: From 20 ft. to 40 ft., From . ft. to . ft.

6 GROUT MATERIAL: 3 1 Neat cement 2 Cement grout 3 Bentonite 4 Other .
 Grout Intervals: From 0 ft. to 20 ft., From . ft. to . ft., From . ft. to . ft.
 What is the nearest source of possible contamination: None 10 Livestock pens 14 Abandoned water well
 1 Septic tank 4 Lateral lines 7 Pit privy 11 Fuel storage 15 Oil well/Gas well
 2 Sewer lines 5 Cess pool 8 Sewage lagoon 12 Fertilizer storage 16 Other (specify below)
 3 Watertight sewer lines 6 Seepage pit 9 Feedyard 13 Insecticide storage

Direction from well?		LITHOLOGIC LOG		PLUGGING INTERVALS	
FROM	TO		FROM	TO	
0	8	Topsoil			
8	15	Gravel			
15	23	Gumbo			
23	30	River mud, gravel layers			
30	40	Shale			

7 CONTRACTOR'S OR LANDOWNER'S CERTIFICATION: This water well was (1) constructed, (2) reconstructed, or (3) plugged under my jurisdiction and was completed on (mo/day/year) 12/15/95 and this record is true to the best of my knowledge and belief. Kansas Water Well Contractor's License No. 199 This Water Well Record was completed on (mo/day/yr) 1/5/96 under the business name of Karst Water Well Drilling & Service, Inc. by (signature)