

WATER WELL RECORD Form WWC-5


Original Record Correction Change in Well Use

Division of Water Resources App. No.

Well ID

1 LOCATION OF WATER WELL: County: Osborne Fraction: 1/4 SE 1/4 SE 1/4 SE 1/4 Section Number: 1 Township Number: T 9 S Range Number: R 15 E W

2 WELL OWNER: Last Name: Kpelling First: Warren Street or Rural Address where well is located: 2454 W. 177th Dr Alton KS 67623

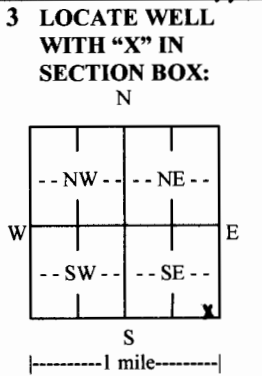

4 DEPTH OF COMPLETED WELL: 35 ft. Depth(s) Groundwater Encountered: 1) 3.5 ft. 2) 2.3 ft. WELL'S STATIC WATER LEVEL: 8-4-15

5 Latitude: Longitude: Datum: Source for Latitude/Longitude: 6 Elevation: Source:

7 WELL WATER TO BE USED AS: 1. Domestic: [ ] Household [ ] Lawn & Garden [x] Livestock 2. [ ] Irrigation 3. [ ] Feedlot 4. [ ] Industrial 5. [ ] Public Water Supply: well ID 6. [ ] Dewatering: how many wells? 7. [ ] Aquifer Recharge: well ID 8. [ ] Monitoring: well ID 9. Environmental Remediation: well ID 10. [ ] Oil Field Water Supply: lease 11. Test Hole: well ID 12. Geothermal: how many bores? 13. Other (specify):

Was a chemical/bacteriological sample submitted to KDHE? [ ] Yes [x] No If yes, date sample was submitted:

8 TYPE OF CASING USED: [ ] Steel [x] PVC [ ] Other CASING JOINTS: [x] Glued [ ] Clamped [ ] Welded [ ] Threaded Casing diameter: 5 in. to 3.5 ft. Diameter: 24 in. Weight: SDR 21

9 GROUT MATERIAL: [ ] Neat cement [ ] Cement grout [x] Bentonite [ ] Other Grout Intervals: From 0 ft. to 20 ft. to 0 ft.

Nearest source of possible contamination: [ ] Septic Tank [ ] Lateral Lines [ ] Pit Privy [ ] Livestock Pens [ ] Insecticide Storage [ ] Sewer Lines [ ] Cess Pool [ ] Sewage Lagoon [ ] Fuel Storage [ ] Abandoned Water Well [ ] Watertight Sewer Lines [ ] Seepage Pit [ ] Feedyard [ ] Fertilizer Storage [ ] Oil Well/Gas Well

LITHOLOGIC LOG table with columns: 10 FROM, TO, LITHOLOGIC LOG, FROM, TO, LITHO. LOG (cont.) or PLUGGING INTERVALS. Rows: 0-3 TOPSOIL, 3-20 Brown clay + limestone, 20-35 clay, Rock, sand, shale.

11 CONTRACTOR'S OR LANDOWNER'S CERTIFICATION: This water well was [x] constructed, [ ] reconstructed, or [ ] plugged under my jurisdiction and was completed on (mo-day-year) 8-4-15 and this record is true to the best of my knowledge and belief.