

WATER WELL RECORD

Form WWC-5


Division of Water Resources App. No.

1 LOCATION OF WATER WELL: County: Rooks	Fraction NW ¼ NW ¼ NW ¼ ¼	Section Number 32	Township No. T 9 S	Range Number R 16 <input type="checkbox"/> E <input checked="" type="checkbox"/> W
---	------------------------------	----------------------	-----------------------	---

Street/Rural Address of Well Location; if unknown, distance & direction from nearest town or intersection: If at owner's address, check here .
From Plainville, KS, E on K18 to 26 rd north to X rd

Global Positioning System (GPS) information:
Latitude: (in decimal degrees)
Longitude: (in decimal degrees)
Elevation:
Datum: WGS 84, NAD 83, NAD 27
Collection Method:
 GPS unit (Make/Model:)
 Digital Map/Photo, Topographic Map, Land Survey
Est. Accuracy: <3 m, 3-5 m, 5-15 m, >15 m

2 WATER WELL OWNER: Liberty Ranch
RR#, Street Address, Box #: 308 W. Mill
City, State, ZIP Code : Plainville, Ks 67663

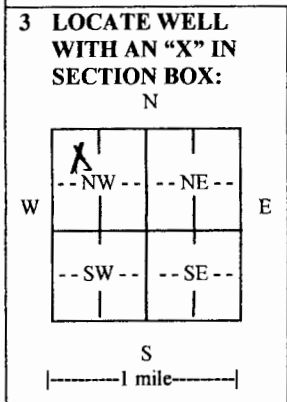

4 DEPTH OF COMPLETED WELL 105 ft.

Depth(s) Groundwater Encountered (1).70 ft. (2).81 ft. (3)..... ft.

WELL'S STATIC WATER LEVEL 50 ft. below land surface measured on mo/day/yr. 06/03/14.....

Pump test data: Well water was .97 ft. after .10 hours pumping. 6 gpm
EST. YIELD. 6 gpm. Well water was ft. after hours pumping..... gpm

Bore Hole Diameter 10 in. to .105 ft., and in. to ft.

WELL WATER TO BE USED AS: Public water supply Geothermal Injection well
 Domestic Feedlot Oil field water supply Dewatering Other (Specify below)
 Irrigation Industrial Domestic-lawn & garden Monitoring well

Was a chemical/bacteriological sample submitted to Department? Yes No
If yes, mo/day/yr sample was submitted.....

Water well disinfected? Yes No

5 TYPE OF CASING USED: Steel PVC Other

CASING JOINTS: Glued Clamped Welded Threaded
Casing diameter .5 in. to .105 ft., Diameter in. to ft., Diameter in. to ft.
Casing height above land surface .36 in., Weight 2.91 lbs./ft., Wall thickness or gauge No. .21

TYPE OF SCREEN OR PERFORATION MATERIAL:
 Steel Stainless Steel PVC Other (Specify)
 Brass Galvanized Steel None used (open hole)

SCREEN OR PERFORATION OPENINGS ARE:
 Continuous slot Mill slot Gauze wrapped Torch cut Drilled holes None (open hole)
 Louvered shutter Key punched Wire wrapped Saw cut Other (specify)

SCREEN-PERFORATED INTERVALS: From 105 ft. to 65 ft., From ft. to ft.
From ft. to ft., From ft. to ft.

GRAVEL PACK INTERVALS: From 105 ft. to 20 ft., From ft. to ft.
From ft. to ft., From ft. to ft.

6 GROUT MATERIAL: Neat cement Cement grout Bentonite Other

Grout Intervals: From 20 ft. to 0 ft., From ft. to ft., From ft. to ft.

What is the nearest source of possible contamination:
 Septic tank Lateral lines Pit privy Livestock pens Insecticide storage Other (specify below)
 Sewer lines Cesspool Sewage lagoon Fuel storage Abandoned water well
 Watertight sewer lines Seepage pit Feedyard Fertilizer storage Oil well/gas well

Direction from well Distance from well

FROM	TO	LITHOLOGIC LOG	FROM	TO	LITHO. LOG (cont.) or PLUGGING INTERVALS
0	1	Top Soil			
2	10	Silt w/clay			
10	30	Limestone Clay			
30	45	Limestone & white clay			
45	69	Limestone clay			
69	72	Fine Rock sand			
72	80	Limestone clay			
80	84	Fine rock and sand			
84	90	shale & rock			
90	105	Shale			

7 CONTRACTOR'S OR LANDOWNER'S CERTIFICATION: This water well was constructed, reconstructed, or plugged under my jurisdiction and was completed on (mo/day/year) 06/05/14..... and this record is true to the best of my knowledge and belief.
Kansas Water Well Contractor's License No. 0199..... This Water Well Record was completed on (mo/day/year) 06/13/14.....
under the business name of Karst Water Well Drilling & Service, Inc..... by (signature)

INSTRUCTIONS: Use typewriter or ball point pen. PLEASE PRESS FIRMLY and PRINT clearly. Please fill in blanks and check the correct answers. Send one copy to Kansas Department of Health and Environment, Bureau of Water, Geology Section, 1000 SW Jackson St., Suite 420, Topeka, Kansas 66612-1367. Telephone 785-296-5524. Send one copy to WATER WELL OWNER and retain one for your records. Include fee of \$5.00 for each constructed well. Visit us at <http://www.kdheks.gov/waterwell/index.html>