


1 LOCATION OF WATER WELL: Fraction NE 1/4 NE 1/4 SE 1/4 Section Number 29 Township Number T 9 S Range Number R 17 E/W  
 County: Rooks

Distance and direction from nearest town or city street address of well if located within city?  
3 miles East of Plainville

2 WATER WELL OWNER: John Crawford  
 RR#, St. Address, Box #: Pt. 2 Box 37-A  
 City, State, ZIP Code: Plainville KS 67663  
 Board of Agriculture, Division of Water Resources  
 Application Number:

3 LOCATE WELL'S LOCATION WITH AN "X" IN SECTION BOX:

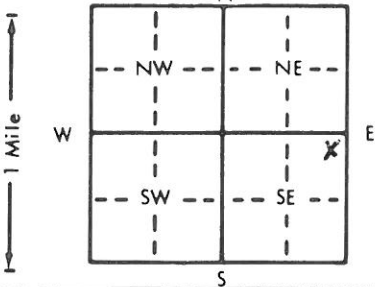

4 DEPTH OF COMPLETED WELL: 60 ft. ELEVATION: N/A  
 Depth(s) Groundwater Encountered 1. 35 ft. 2. ft. 3. ft.  
 WELL'S STATIC WATER LEVEL: 36 ft. below land surface measured on mo/day/yr 7-9-96  
 Pump test data: Well water was 41 ft. after 1 1/2 hours pumping 18 gpm  
 Est. Yield 15 gpm Well water was 44 ft. after 1 1/2 hours pumping 18 gpm  
 Bore Hole Diameter: 9 in. to 60 ft., and . in. to . ft.

WELL WATER TO BE USED AS:  
 1 Domestic     3 Feedlot     6 Oil field water supply     9 Dewatering     12 Other (Specify below)  
 2 Irrigation     4 Industrial     7 Lawn and garden only     10 Monitoring well  
 Was a chemical/bacteriological sample submitted to Department? Yes..... No ; If yes, mo/day/yr sample was submitted  
 Water Well Disinfected?  Yes    No

5 TYPE OF BLANK CASING USED:  
 1 Steel     3 RMP (SR)     5 Wrought iron     8 Concrete tile    CASING JOINTS:  Glued     Clamped  
 2 PVC     4 ABS     6 Asbestos-Cement     9 Other (specify below)     Welded  
 7 Fiberglass     Threaded

Blank casing diameter: 5 in. to 40 ft., Dia. in. to . ft., Dia. in. to . ft.  
 Casing height above land surface: 18 in., weight lbs./ft. Wall thickness or gauge No. SDR 21

TYPE OF SCREEN OR PERFORATION MATERIAL:  
 1 Steel     3 Stainless steel     5 Fiberglass     7 PVC     10 Asbestos-cement  
 2 Brass     4 Galvanized steel     6 Concrete tile     8 RMP (SR)     11 Other (specify)  
 12 None used (open hole)

SCREEN OR PERFORATION OPENINGS ARE:  
 1 Continuous slot     3 Mill slot     5 Gauzed wrapped     8 Saw cut     11 None (open hole)  
 2 Louvered shutter     4 Key punched     6 Wire wrapped     9 Drilled holes  
 7 Torch cut     10 Other (specify)

SCREEN-PERFORATED INTERVALS: From 40 ft. to 60 ft., From . ft. to . ft.  
 From . ft. to . ft., From . ft. to . ft.  
 GRAVEL PACK INTERVALS: From 60 ft. to 25 ft., From . ft. to . ft.  
 From . ft. to . ft., From . ft. to . ft.

6 GROUT MATERIAL:  1 Neat cement     2 Cement grout     3 Bentonite     4 Other  
 Grout Intervals: From 25 ft. to 5 ft., From . ft. to . ft., From . ft. to . ft.

What is the nearest source of possible contamination:  
 1 Septic tank     4 Lateral lines     7 Pit privy     10 Livestock pens     14 Abandoned water well  
 2 Sewer lines     5 Cess pool     8 Sewage lagoon     11 Fuel storage     15 Oil well/Gas well  
 3 Watertight sewer lines     6 Seepage pit     9 Feedyard     12 Fertilizer storage     16 Other (specify below)  
 13 Insecticide storage

Direction from well? How many feet? 150' Wpst

FROM	TO	LITHOLOGIC LOG	FROM	TO	PLUGGING INTERVALS
0	6	loess			
6	35	lost circulation, clay, vif. sd. loess			
35	40	clay w/ sd increasing			
40	56	well sorted, mature sd, mal gravel			
56	57	white, lms gravel			
57	59	clay white			
59	60	Blue-gray shale			

7 CONTRACTOR'S OR LANDOWNER'S CERTIFICATION: This water well was  (1) constructed,  (2) reconstructed, or  (3) plugged under my jurisdiction and was completed on (mo/day/year) 7-9-96 and this record is true to the best of my knowledge and belief. Kansas Water Well Contractor's License No. 608 This Water Well Record was completed on (mo/day/yr) 8-2-96 under the business name of Yellow Jacket Drilling by (signature) [Signature]

INSTRUCTIONS: Use typewriter or ball point pen. PLEASE PRESS FIRMLY and PRINT clearly. Please fill in blanks, underline or circle the correct answers. Send top three copies to Kansas Department of Health and Environment, Bureau of Water, Topeka, Kansas 66620-0001. Telephone: 913-296-5545. Send one to WATER WELL OWNER and retain one for your records.