

WATER WELL RECORD

Form WWC-5


Division of Water Resources App. No.

1002

1 LOCATION OF WATER WELL: County: Rooks Fraction SW, SW, SW SE 1/4 SE 1/4 NW 1/4 Section Number 27 Township No. T 9 S Range Number R 17 E W

Street/Rural Address of Well Location; if unknown, distance & direction from nearest town or intersection: 4 miles east, 1/4 mile north of Plainville, KS 67663 Global Positioning System (GPS) information: Latitude: Longitude: Elevation: Datum: Collection Method: Est. Accuracy:

2 WATER WELL OWNER: Ted Swafford RR#, Street Address, Box #: 1845 HWY 18 City, State, ZIP Code : Plainville, KS 67663

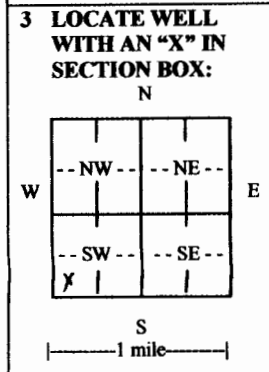

3 LOCATE WELL WITH AN 'X' IN SECTION BOX: 4 DEPTH OF COMPLETED WELL 35 ft. Depth(s) Groundwater Encountered (1) ft. (2) ft. (3) ft. WELL'S STATIC WATER LEVEL 22 ft. below land surface measured on mo/day/yr. Pump test data: Well water was 22 ft. after 10 hours pumping 10 gpm EST. YIELD 10 gpm. Well water was ft. after hours pumping gpm Bore Hole Diameter in. to ft., and in. to ft. WELL WATER TO BE USED AS: Domestic, Feedlot, Oil field water supply, Geothermal, Injection well, Irrigation, Industrial, Domestic-lawn & garden, Monitoring well. Was a chemical/bacteriological sample submitted to Department? Yes No. If yes, mo/day/yr sample was submitted. Water well disinfected? Yes No

5 TYPE OF CASING USED: Steel PVC Other CASING JOINTS: Glued Clamped Welded Threaded Casing diameter .5 in. to .35 ft., Diameter in. to ft., Diameter in. to ft. Casing height above land surface .16 in., Weight 2.91 lbs./ft., Wall thickness or gauge No. 21

TYPE OF SCREEN OR PERFORATION MATERIAL: Steel Stainless Steel PVC Other (Specify) Brass Galvanized Steel None used (open hole) SCREEN OR PERFORATION OPENINGS ARE: Continuous slot Mill slot Gauze wrapped Torch cut Drilled holes None (open hole) Louvered shutter Key punched Wire wrapped Saw cut Other (specify) SCREEN-PERFORATED INTERVALS: From 35 ft. to 15 ft., From ft. to ft. GRAVEL PACK INTERVALS: From 35 ft. to 14 ft., From ft. to ft. From ft. to ft. From ft. to ft.

6 GROUT MATERIAL: Neat cement Cement grout Bentonite Other Grout Intervals: From 14 ft. to 0 ft., From ft. to ft., From ft. to ft. What is the nearest source of possible contamination: Septic tank Lateral lines Pit privy Livestock pens Insecticide storage Other (specify below) Sewer lines Cesspool Sewage lagoon Fuel storage Abandoned water well Watertight sewer lines Seepage pit Feedyard Fertilizer storage Oil well/gas well Direction from well Distance from well

Table with columns: FROM, TO, LITHOLOGIC LOG, FROM, TO, LITHO. LOG (cont.) or PLUGGING INTERVALS. Rows: 0-4 Top Soil, 4-15 Gumbo, 15-20 Fine Sand, 20-23 Sand, 23-30 Clay, 30-35 Shale.

7 CONTRACTOR'S OR LANDOWNER'S CERTIFICATION: This water well was constructed, reconstructed, or plugged under my jurisdiction and was completed on (mo/day/year) 12/01/09 and this record is true to the best of my knowledge and belief. Kansas Water Well Contractor's License No. 0199. This Water Well Record was completed on (mo/day/year) 12/16/09 under the business name of Karst Water Well Drilling & Service, Inc. by (signature)

INSTRUCTIONS: Use typewriter or ball point pen. PLEASE PRESS FIRMLY and PRINT clearly. Please fill in blanks and check the correct answers. Send three copies (white, blue, pink) to Kansas Department of Health and Environment, Bureau of Water, Geology Section, 1000 SW Jackson St., Suite 420, Topeka, Kansas 66612-1367. Telephone 785-296-5522. Send one copy to WATER WELL OWNER and retain one for your records. Include fee of \$5.00 for each constructed well. Visit us at http://www.kdheks.gov/waterwell/index.html.