


1 LOCATION OF WATER WELL: County: Rooks Fraction: SW 1/4 SW 1/4 NW 1/4 Section Number: 35 Township Number: T 9 S Range Number: R 18 E/W

Distance and direction from nearest town or city street address of well if located within city?
Backyard 701 S. Cochran Plainville, Kansas 67663

2 WATER WELL OWNER: Jerry Staab
 RR#, St. Address, Box #: 701 S. Cochran
 City, State, ZIP Code: Plainville, Ks. 67663
 Board of Agriculture, Division of Water Resources
 Application Number:

3 LOCATE WELL'S LOCATION WITH AN "X" IN SECTION BOX:

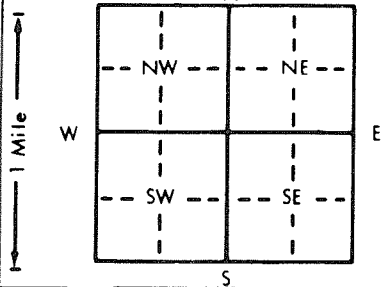

4 DEPTH OF COMPLETED WELL: 73 ft. ELEVATION: NA
 Depth(s) Groundwater Encountered 1. 33 ft. 2. _____ ft. 3. _____ ft.
 WELL'S STATIC WATER LEVEL 33 ft. below land surface measured on 6-4-96
 Pump test data: Well water was 63 ft. after 1 hours pumping 18 GPM gpm
 Est. Yield 16 gpm: Well water was _____ ft. after _____ hours pumping _____ gpm
 Bore Hole Diameter: 9 in. to 73 ft., and _____ in. to _____ ft.
 WELL WATER TO BE USED AS:
 5 Public water supply 8 Air conditioning 11 Injection well
 1 Domestic 3 Feedlot 6 Oil field water supply 9 Dewatering 12 Other (Specify below)
 2 Irrigation 4 Industrial 7 Lawn and garden only 10 Monitoring well
 Was a chemical/bacteriological sample submitted to Department? Yes _____ No If yes, mo/day/yr sample was submitted _____
 Water Well Disinfected? Yes No

5 TYPE OF BLANK CASING USED:
 1 Steel 3 RMP (SR) 5 Wrought iron 8 Concrete tile CASING JOINTS: Glued _____ Clamped _____
2 PVC 4 ABS 6 Asbestos-Cement 9 Other (specify below) Splined Certa-lok Welded _____
 7 Fiberglass Threaded _____
 Blank casing diameter 5 in. to 33 ft., Dia 5 1/2 in. to _____ ft., Dia _____ in. to _____ ft.
 Casing height above land surface 18 in., weight _____ lbs./ft. Wall thickness or gauge No. SDR-21
 TYPE OF SCREEN OR PERFORATION MATERIAL:
 1 Steel 3 Stainless steel 5 Fiberglass 8 RMP (SR) 10 Asbestos-cement
 2 Brass 4 Galvanized steel 6 Concrete tile 9 ABS 11 Other (specify) _____
 12 None used (open hole)
 SCREEN OR PERFORATION OPENINGS ARE:
 1 Continuous slot 3 Mill slot 5 Gauzed wrapped 8 Saw cut 11 None (open hole)
 2 Louvered shutter 4 Key punched 6 Wire wrapped 9 Drilled holes
 7 Torch cut 10 Other (specify) _____
 SCREEN-PERFORATED INTERVALS: From 33 ft. to 73 ft., From _____ ft. to _____ ft.
 From _____ ft. to _____ ft., From _____ ft. to _____ ft.
 GRAVEL PACK INTERVALS: From 73 ft. to 25 ft., From _____ ft. to _____ ft.
 From _____ ft. to _____ ft., From _____ ft. to _____ ft.

6 GROUT MATERIAL: 1 Neat cement 2 Cement grout 3 Bentonite 4 Other _____
 Grout Intervals: From 25 ft. to Surface ft., From _____ ft. to _____ ft., From _____ ft. to _____ ft.
 What is the nearest source of possible contamination:
 1 Septic tank 4 Lateral lines 7 Pit privy 10 Livestock pens 14 Abandoned water well
 2 Sewer lines 5 Cess pool 8 Sewage lagoon 11 Fuel storage 15 Oil well/Gas well
3 Watertight sewer lines 6 Seepage pit 9 Feedyard 12 Fertilizer storage 16 Other (specify below)
 13 Insecticide storage
 Direction from well? South How many feet? 35'

FROM	TO	LITHOLOGIC LOG	FROM	TO	PLUGGING INTERVALS
0	7	loess			
7	23	brn. clay			
23	33	brn. clay (w/ intermittent lms.			
33	48	lt. brn. clay (w/ med gr. sd lens 80% clay 20% sd)			
48	53	greenish clay, slightly sdy			
53	63	white stickly highly sat. clay			
63	67	greenish & brown streaked clay			
67	73	weathered shale grading to hard fissle shale.			

7 CONTRACTOR'S OR LANDOWNER'S CERTIFICATION: This water well was (1) constructed, (2) reconstructed, or (3) plugged under my jurisdiction and was completed on (mo/day/year) 6-4-96 and this record is true to the best of my knowledge and belief. Kansas Water Well Contractor's License No. 608 This Water Well Record was completed on (mo/day/yr) 6-29-96 under the business name of Yellow Jacket Drilling by (signature) Eri T. Wadell