


1 LOCATION OF WATER WELL: County: Rooks Fraction: NE 1/4 NE 1/4 SW 1/4 Section Number: 28 Township Number: T 9 S Range Number: R 18 EW

Distance and direction from nearest town or city street address of well if located within city?
2 Blk north K-18 and 2 Blks west 183 Hwy Jct.

2 WATER WELL OWNER: Tom Albert
 RR#, St. Address, Box #: 433 SE 3
 City, State, ZIP Code: Plainville, KS 67463
 Board of Agriculture, Division of Water Resources
 Application Number:

3 LOCATE WELL'S LOCATION WITH AN "X" IN SECTION BOX: 4 DEPTH OF COMPLETED WELL: 67 ft. ELEVATION: N/A

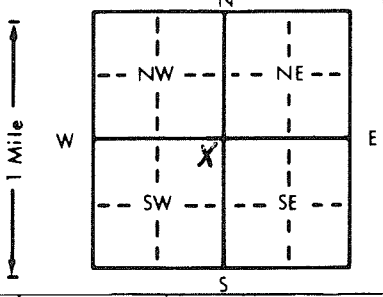

Depth(s) Groundwater Encountered 1. 20 ft. 2. _____ ft. 3. _____ ft.
 WELL'S STATIC WATER LEVEL 20 ft. below land surface measured on 8-19-94
 Pump test data: Well water was 23.85 ft. after 1 hours pumping 15 gpm
 Est. Yield 30 gpm: Well water was 240.1 ft. after 1.12 hours pumping 1.8 gpm
 Bore Hole Diameter: 7.124 in. to 7.10 in. to _____ in. to _____ in.
 WELL WATER TO BE USED AS:
 1 Domestic 3 Feedlot 6 Oil field water supply 9 Dewatering 12 Other (Specify below)
 2 Irrigation 4 Industrial 7 Lawn and garden only 10 Monitoring well
 Was a chemical/bacteriological sample submitted to Department? Yes No; If yes, mo/day/yr sample was submitted _____
 Water Well Disinfected? Yes No

5 TYPE OF BLANK CASING USED:
 1 Steel 3 RMP (SR) 6 Asbestos-Cement 9 Other (specify below)
2 PVC 4 ABS 7 Fiberglass
 CASING JOINTS: Glued Clamped Welded Threaded

Blank casing diameter 5 in. to 27 ft., Dia 5 in. to 57 ft., Dia 6.7 in. to _____ ft.
 Casing height above land surface 20 in., weight _____ lbs./ft. Wall thickness or gauge No. SDR 21

TYPE OF SCREEN OR PERFORATION MATERIAL:
 1 Steel 3 Stainless steel 5 Fiberglass 7 PVC 10 Asbestos-cement
 2 Brass 4 Galvanized steel 6 Concrete tile 8 RMP (SR) 11 Other (specify)
 12 None used (open hole)

SCREEN OR PERFORATION OPENINGS ARE:
 1 Continuous slot 3 Mill slot 5 Gauzed wrapped 8 Saw cut 11 None (open hole)
 2 Louvered shutter 4 Key punched 6 Wire wrapped 9 Drilled holes 10 Other (specify)

SCREEN-PERFORATED INTERVALS: From 5.7 ft. to 27 ft., From _____ ft. to _____ ft.
 From _____ ft. to _____ ft., From _____ ft. to _____ ft.
 GRAVEL PACK INTERVALS: From 6.7 ft. to 20 ft., From _____ ft. to _____ ft.
 From _____ ft. to _____ ft., From _____ ft. to _____ ft.

6 GROUT MATERIAL: 1 Neat cement 2 Cement grout 3 Bentonite 4 Other
 Grout Intervals: From 25 ft. to 3 ft., From _____ ft. to _____ ft., From _____ ft. to _____ ft.

What is the nearest source of possible contamination:
 1 Septic tank 4 Lateral lines 7 Pit privy 11 Fuel storage 14 Abandoned water well
 2 Sewer lines 5 Cess pool 8 Sewage lagoon 12 Fertilizer storage 15 Oil well/Gas well
3 Watertight sewer lines 6 Seepage pit 9 Feedyard 13 Insecticide storage 16 Other (specify below)
 Direction from well? How many feet? 125'

FROM	TO	LITHOLOGIC LOG	FROM	TO	PLUGGING INTERVALS
0	2.5	loess			
2.5	6	clay drk soil, (kragg)			
6	11	clay cream			
11	16	clay white			
16	20	lms, white			
20	24	sd, fine to silty mat, rd, sub mat			
24	24	sd, lms			
26	30	sugar sd			
30	46	sd, clay			
46	58	sd, cream saturated clay			
58	65	clay white - yellow			
65	67	shale brownish - gray			

7 CONTRACTOR'S OR LANDOWNER'S CERTIFICATION: This water well was 1 constructed, (2) reconstructed, or (3) plugged under my jurisdiction and was completed on (mo/day/year) 8-19-96 and this record is true to the best of my knowledge and belief. Kansas Water Well Contractor's License No. 6008 This Water Well Record was completed on (mo/day/yr) 9-16-96 under the business name of Yellow Jacket Drilling by (signature) E. J. Woodell

INSTRUCTIONS: Use typewriter or ball point pen. PLEASE PRESS FIRMLY and PRINT clearly. Please fill in blanks, underline or circle the correct answers. Send top three copies to Kansas Department of Health and Environment, Bureau of Water, Topeka, Kansas 66620-0001. Telephone: 913-296-5545. Send one to WATER WELL OWNER and retain one for your records.