


1 LOCATION OF WATER WELL: County: Rooks Fraction: SE 1/4 SE 1/4 SW 1/4 Section Number: 26 Township Number: T 9 S Range Number: R 18 EW  
 Distance and direction from nearest town or city street address of well if located within city?  
101 N. Washington, Plainville, KS.

2 WATER WELL OWNER: Don Languen  
 RR#, St. Address, Box #: 101 N. Washington Board of Agriculture, Division of Water Resources  
 City, State, ZIP Code: Plainville, Ks. Application Number:

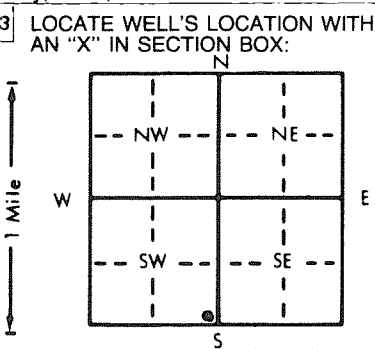

4 DEPTH OF COMPLETED WELL: 20' ft. ELEVATION:  
 Depth(s) Groundwater Encountered 1. 15' ft. 2. ft. 3. ft.  
 WELL'S STATIC WATER LEVEL: 152" ft. below land surface measured on mo/day/yr 12-30-96  
 Pump test data: Well water was ft. after hours pumping gpm  
 Est. Yield gpm: Well water was ft. after hours pumping gpm  
 Bore Hole Diameter: 8 1/2" in. to 20' ft. and in. to ft.  
 WELL WATER TO BE USED AS:  
 1 Domestic 3 Feedlot 5 Public water supply 8 Air conditioning 11 Injection well  
 2 Irrigation 4 Industrial 6 Oil field water supply 9 Dewatering 12 Other (Specify below)  
 7 Lawn and garden only  10 Monitoring well  
 Was a chemical/bacteriological sample submitted to Department? Yes.....No.  If yes, mo/day/yr sample was submitted  
 Water Well Disinfected? Yes  No

5 TYPE OF BLANK CASING USED:  
 1 Steel 3 RMP (SR) 5 Wrought iron 8 Concrete tile CASING JOINTS: Glued Clamped  
 2 PVC 4 ABS 6 Asbestos-Cement 9 Other (specify below) Welded  
 7 Fiberglass Threaded   
 Blank casing diameter 2.375 in. to 10' ft. Dia. in. to SDR 13 ft.  
 Casing height above land surface: Flush in., weight lbs./ft. Wall thickness or gauge No. SCH 40  
 TYPE OF SCREEN OR PERFORATION MATERIAL:  
 1 Steel 3 Stainless steel 5 Fiberglass 8 RMP (SR) 10 Asbestos-cement  
 2 Brass 4 Galvanized steel 6 Concrete tile 9 ABS 11 Other (specify)  
 12 None used (open hole)  
 SCREEN OR PERFORATION OPENINGS ARE:  
 1 Continuous slot 3 Mill slot 5 Gauzed wrapped 8 Saw cut 11 None (open hole)  
 2 Louvered shutter 4 Key punched 6 Wire wrapped 9 Drilled holes  
 7 Torch cut 10 Other (specify)  
 SCREEN-PERFORATED INTERVALS: From 20' ft. to 10' ft. From ft. to ft.  
 From ft. to ft. From ft. to ft.  
 GRAVEL PACK INTERVALS: From 20' ft. to 8' ft. From ft. to ft.  
 From ft. to ft. From ft. to ft.

6 GROUT MATERIAL: 1 Neat cement 2 Cement grout 3 Bentonite 4 Other  
 Grout Intervals: From 8' ft. to 4' ft. From 4' ft. to 0' ft. From ft. to ft.  
 What is the nearest source of possible contamination:  
 1 Septic tank 4 Lateral lines 7 Pit privy 10 Livestock pens 14 Abandoned water well  
 2 Sewer lines 5 Cess pool 8 Sewage lagoon 11 Fuel storage 15 Oil well/Gas well  
 3 Watertight sewer lines 6 Seepage pit 9 Feedyard 12 Fertilizer storage 16 Other (specify below)  
 13 Insecticide storage  
 Direction from well? North How many feet? 10'

FROM	TO	LITHOLOGIC LOG	FROM	TO	PLUGGING INTERVALS
0	.50	Gravel			
.50	4.50	Dk brn clay, moist to dry, no odor, firm, low plasticity.			
4.50	6.25	Lt. brn-pale gray brn silty clay, moist, firm, no odor.			
6.25	12.50	Lt. gray silty clay, moist, firm, slight oxide staining, no odor.			
12.50	15	Green gray sandy clay, fine-coarse sand, moist, no odor.			
15	20	Dk gray sand, fine-coarse, wet, strong odor, poorly sorted.			

*F.M. OK'd by Don Taylor*

7 CONTRACTOR'S OR LANDOWNER'S CERTIFICATION: This water well was (1)  constructed, (2) reconstructed, or (3) plugged under my jurisdiction and was completed on (mo/day/year) 12-30-96 and this record is true to the best of my knowledge and belief. Kansas Water Well Contractor's License No. 539 This Water Well Record was completed on (mo/day/yr) 1-8-97 under the business name of JB Environmental Drilling by (signature) James Bieber

INSTRUCTIONS: Use typewriter or ball point pen. PLEASE PRESS FIRMLY and PRINT clearly. Please fill in blanks, underline or circle the correct answers. Send top three copies to Kansas Department of Health and Environment, Bureau of Water, Topeka, Kansas 66620-0001. Telephone: 913-296-5545. Send one to WATER WELL OWNER and retain one for your records.

OFFICE USE ONLY T R EW SEC. 1/4 1/4 1/4