


1 LOCATION OF WATER WELL: County: Rooks Fraction: NE 1/4 NE 1/4 NW 1/4 Section Number: 35 Township Number: T 9 S Range Number: R 18 EW

Distance and direction from nearest town or city street address of well if located within city?
101 N. Washington, Plainville, KS.

2 WATER WELL OWNER: Don Languelin
 RR#, St. Address, Box #: 101 N. Washington
 City, State, ZIP Code: Plainville, Ks.
 Board of Agriculture, Division of Water Resources
 Application Number: _____

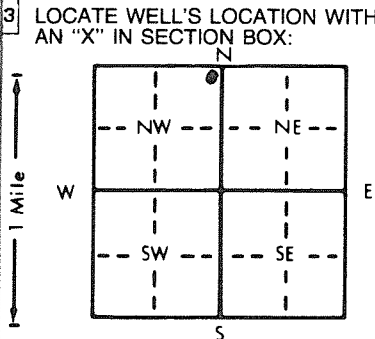

4 DEPTH OF COMPLETED WELL: 23' ft. ELEVATION: _____
 Depth(s) Groundwater Encountered: 1.17' ft. 2. _____ ft. 3. _____ ft.
 WELL'S STATIC WATER LEVEL: 15.8 ft. below land surface measured on mo/day/yr 12-31-96
 Pump test data: Well water was _____ ft. after _____ hours pumping _____ gpm
 Est. Yield _____ gpm; Well water was _____ ft. after _____ hours pumping _____ gpm
 Bore Hole Diameter: 3 1/2 in. to 23' ft., and _____ in. to _____ ft.
 WELL WATER TO BE USED AS:
 5 Public water supply 8 Air conditioning 11 Injection well
 1 Domestic 3 Feedlot 6 Oil field water supply 9 Dewatering 12 Other (Specify below)
 2 Irrigation 4 Industrial 7 Lawn and garden only 10 Monitoring well
 Was a chemical/bacteriological sample submitted to Department? Yes _____ No X; If yes, mo/day/yr sample was submitted _____
 Water Well Disinfected? Yes _____ No X

5 TYPE OF BLANK CASING USED:
 1 Steel 3 RMP (SR) 5 Wrought iron 8 Concrete tile CASING JOINTS: Glued _____ Clamped _____
2 PVC 4 ABS 6 Asbestos-Cement 9 Other (specify below) Welded _____
 7 Fiberglass _____ Threaded X
 Blank casing diameter: 23.75 in. to 13' ft., Dia _____ in. to _____ ft., Dia _____ in. to _____ ft., Dia _____ in. to _____ ft.
 Casing height above land surface: FLUSH Mt. in., weight _____ lbs./ft. Wall thickness or gauge No. _____ SCH 4.0
 TYPE OF SCREEN OR PERFORATION MATERIAL:
 1 Steel 3 Stainless steel 5 Fiberglass 8 RMP (SR) 10 Asbestos-cement
 2 Brass 4 Galvanized steel 6 Concrete tile 9 ABS 11 Other (specify) _____
 12 None used (open hole)
 SCREEN OR PERFORATION OPENINGS ARE:
 1 Continuous slot 3 Mill slot 5 Gauzed wrapped 8 Saw cut 11 None (open hole)
 2 Louvered shutter 4 Key punched 6 Wire wrapped 9 Drilled holes
 7 Torch cut 10 Other (specify) _____
 SCREEN-PERFORATED INTERVALS: From 23' ft. to 13' ft., From _____ ft. to _____ ft.
 From _____ ft. to _____ ft., From _____ ft. to _____ ft.
 GRAVEL PACK INTERVALS: From 23' ft. to 11' ft., From _____ ft. to _____ ft.
 From _____ ft. to _____ ft., From _____ ft. to _____ ft.

6 GROUT MATERIAL: 1 Neat cement 2 Cement grout 3 Bentonite 4 Other
 Grout Intervals: From 11' ft. to 4' ft., From 4' ft. to 0' ft., From _____ ft. to _____ ft.
 What is the nearest source of possible contamination:
 1 Septic tank 4 Lateral lines 7 Pit privy 10 Livestock pens 14 Abandoned water well
 2 Sewer lines 5 Cess pool 8 Sewage lagoon 11 Fuel storage 15 Oil well/Gas well
 3 Watertight sewer lines 6 Seepage pit 9 Feedyard 12 Fertilizer storage 16 Other (specify below)
 13 Insecticide storage
 Direction from well? North How many feet? 90'

FROM	TO	LITHOLOGIC LOG	FROM	TO	PLUGGING INTERVALS
0	.50	Gravel, ls, rx, Qtz, froze, packed.			
.50	4	Dk-med brn clay, moist, no odor.			
4	7	Gray-gray brn mottled silty clay w/ oxide staining. firm, no odor, med. plasticity.			
7	12	Gray green silty clay w/ oxide staining, no odor, moist, soft, highly plastic.			
12	18	Lt brn silty sandy clay w/ caliche, moist to wet, no odor.			
18	23	White tan fine-coarse sand, wet, no odor, subrounded, well graded.			

F.H. OK'd by Don Taylor

7 CONTRACTOR'S OR LANDOWNER'S CERTIFICATION: This water well was (1) constructed (2) reconstructed, or (3) plugged under my jurisdiction and was completed on (mo/day/year) 12-31-96 and this record is true to the best of my knowledge and belief. Kansas Water Well Contractor's License No. 539 This Water Well Record was completed on (mo/day/yr) 1-8-97 under the business name of JB Environmental Drilling by (signature) James Baker

OFFICE USE ONLY
T
R
EW
SEC.
1/4
1/4