


1 LOCATION OF WATER WELL: Fraction SE 1/4 SE 1/4 SW 1/4 Section Number 26 Township Number T 9 S Range Number R 18 EW
 County: Rooks

Distance and direction from nearest town or city street address of well if located within city?
105 N. Washington, Plainville, KS.

2 WATER WELL OWNER: Plainville Amplus
 RR#, St. Address, Box # : 105 N. Washington Board of Agriculture, Division of Water Resources
 City, State, ZIP Code : Plainville, KS. Application Number:

3 LOCATE WELL'S LOCATION WITH AN "X" IN SECTION BOX:

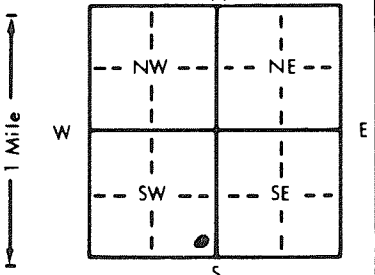

4 DEPTH OF COMPLETED WELL... 26 ft. ELEVATION: ft.
 Depth(s) Groundwater Encountered 1. 18 1/2' ft. 2. ft. 3. ft.
 WELL'S STATIC WATER LEVEL 18:07 ft. below land surface measured on mo/day/yr 1-2-97
 Pump test data: Well water was ft. after hours pumping gpm
 Est. Yield gpm: Well water was ft. after hours pumping gpm
 Bore Hole Diameter... 8 1/2" in. to 26' ft., and in. to ft.
 WELL WATER TO BE USED AS: 5 Public water supply 8 Air conditioning 11 Injection well
 1 Domestic 3 Feedlot 6 Oil field water supply 9 Dewatering 12 Other (Specify below)
 2 Irrigation 4 Industrial 7 Lawn and garden only 10 Monitoring well
 Was a chemical/bacteriological sample submitted to Department? Yes..... No X..... If yes, mo/day/yr sample was sub-
 mitted Water Well Disinfected? Yes No

5 TYPE OF BLANK CASING USED: 5 Wrought iron 8 Concrete tile CASING JOINTS: Glued Clamped
 1 Steel 3 RMP (SR) 6 Asbestos-Cement 9 Other (specify below) Welded
2 PVC 4 ABS 7 Fiberglass Threaded... X.....
 Blank casing diameter 2.375 in. to 16' ft., Dia in. to ft., Dia in. to SDR 13 ft.
 Casing height above land surface: FLUSH Mt. in., weight lbs./ft. Wall thickness or gauge No. ... Sch. 40.....

TYPE OF SCREEN OR PERFORATION MATERIAL: 7 PVC 10 Asbestos-cement
 1 Steel 3 Stainless steel 5 Fiberglass 8 RMP (SR) 11 Other (specify)
 2 Brass 4 Galvanized steel 6 Concrete tile 9 ABS 12 None used (open hole)

SCREEN OR PERFORATION OPENINGS ARE: 5 Gauzed wrapped 8 Saw cut 11 None (open hole)
 1 Continuous slot 3 Mill slot 6 Wire wrapped 9 Drilled holes
 2 Louvered shutter 4 Key punched 7 Torch cut 10 Other (specify)

SCREEN-PERFORATED INTERVALS: From 26' ft. to 16' ft., From ft. to ft.
 From ft. to ft., From ft. to ft.
 GRAVEL PACK INTERVALS: From 26' ft. to 14' ft., From ft. to ft.
 From ft. to ft., From ft. to ft.

6 GROUT MATERIAL: 1 Neat cement 2 Cement grout 3 Bentonite 4 Other
 Grout Intervals: From 14' to 4' ft., From 4' ft. to 0' ft., From ft. to ft.
 What is the nearest source of possible contamination: 3 4 10 14
 1 Septic tank 4 Lateral lines 7 Pit privy 1 Fuel storage 15 Oil well/Gas well
 2 Sewer lines 5 Cess pool 8 Sewage lagoon 12 Fertilizer storage 16 Other (specify below)
 3 Watertight sewer lines 6 Seepage pit 9 Feedyard 13 Insecticide storage
 Direction from well? East How many feet? 80'

FROM	TO	LITHOLOGIC LOG	FROM	TO	PLUGGING INTERVALS
0	1.0	Gravel, ls. rx/Otz			
1.0	5.0	dk Br - Black clay fill w/ls. rx, brick fill dry, no odor			
5.0	7.0	Clay, Br clay w/oxide staining & Hottling Moist, no odor			
7.0	10.50	lt. Br. silty clay, moist, soft, friable no odor			
10.50	18.0	lt. Br. sandy clay w/calc. stringers Moist, soft, no odor, fine-med grained			
18.0	26.0	lt. Gray loam sandy silt to silty sand w/lt, no to faint odor, fine grained sand			
					FLUSH Mt. ok'd by Don Taylor

7 CONTRACTOR'S OR LANDOWNER'S CERTIFICATION: This water well was (1) constructed (2) reconstructed, or (3) plugged under my jurisdiction and was completed on (mo/day/year) 1-2-97 and this record is true to the best of my knowledge and belief. Kansas Water Well Contractor's License No. 539 This Water Well Record was completed on (mo/day/yr) 1-8-97 under the business name of JB Environmental Drilling by signature James Buerer

INSTRUCTIONS: Use typewriter or ball point pen. PLEASE PRESS FIRMLY and PRINT clearly. Please fill in blanks, underline or circle the correct answers. Send top three copies to Kansas Department of Health and Environment, Bureau of Water, Topeka, Kansas 66620-0001. Telephone: 913-296-5545. Send one to WATER WELL OWNER and retain one for your records.

OFFICE USE ONLY
T
R
EW
SEC.
1/4
1/4
1/4