


1 LOCATION OF WATER WELL: County: Rooks Fraction SW 1/4 SW 1/4 SE 1/4 Section Number 26 Township Number T 9 S Range Number R 18 EW

Distance and direction from nearest town or city street address of well if located within city?
105 N. Washington, Plainville, KS.

2 WATER WELL OWNER: Plainville Amplus
 RR#, St. Address, Box #: 105 N. Washington Board of Agriculture, Division of Water Resources
 City, State, ZIP Code: Plainville, KS. Application Number:

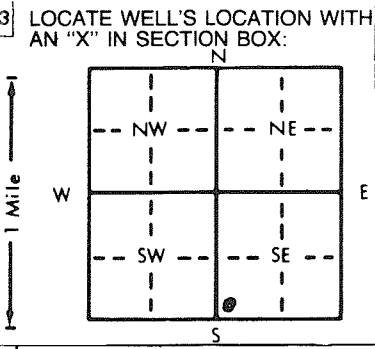

4 DEPTH OF COMPLETED WELL: 24' ft. ELEVATION: _____ ft.
 Depth(s) Groundwater Encountered 1 17 1/2' ft. 2. _____ ft. 3. _____ ft.
 WELL'S STATIC WATER LEVEL 16.10 ft. below land surface measured on mo/day/yr 1-3-97
 Pump test data: Well water was _____ ft. after _____ hours pumping _____ gpm
 Est. Yield _____ gpm; Well water was _____ ft. after _____ hours pumping _____ gpm
 Bore Hole Diameter: 8 1/2" in. to 24" in. to _____ in. to _____ in.
 WELL WATER TO BE USED AS: 5 Public water supply 8 Air conditioning 11 Injection well
 1 Domestic 3 Feedlot 6 Oil field water supply 9 Dewatering 12 Other (Specify below)
 2 Irrigation 4 Industrial 7 Lawn and garden only 10 Monitoring well
 Was a chemical/bacteriological sample submitted to Department? Yes _____ No X; If yes, mo/day/yr sample was submitted _____
 Water Well Disinfected? Yes _____ No (No)

5 TYPE OF BLANK CASING USED: 1 Steel 3 RMP (SR) 5 Wrought iron 8 Concrete tile CASING JOINTS: Glued _____ Clamped _____
2 PVC 4 ABS 6 Asbestos-Cement 9 Other (specify below) Welded _____
 Blank casing diameter 8.375 in. to 14' ft., Dia _____ in. to _____ ft., Dia _____ in. to SDR 13 ft.
 Casing height above land surface: Flush Mt. in., weight _____ lbs./ft. Wall thickness or gauge No. SCh 40
 TYPE OF SCREEN OR PERFORATION MATERIAL: 7 PVC 10 Asbestos-cement
 1 Steel 3 Stainless steel 5 Fiberglass 8 RMP (SR) 11 Other (specify) _____
 2 Brass 4 Galvanized steel 6 Concrete tile 9 ABS 12 None used (open hole)
 SCREEN OR PERFORATION OPENINGS ARE: 5 Gauzed wrapped 8 Saw cut 11 None (open hole)
 1 Continuous slot 6 Mill slot 6 Wire wrapped 9 Drilled holes
 2 Louvered shutter 4 Key punched 7 Torch cut 10 Other (specify) _____
 SCREEN-PERFORATED INTERVALS: From 24' ft. to 14' ft., From _____ ft. to _____ ft.
 From _____ ft. to _____ ft., From _____ ft. to _____ ft.
 GRAVEL PACK INTERVALS: From 24' ft. to 12' ft., From _____ ft. to _____ ft.
 From _____ ft. to _____ ft., From _____ ft. to _____ ft.

6 GROUT MATERIAL: 1 Neat cement 2 Cement grout 3 Bentonite 4 Other _____
 Grout Intervals: From 12' ft. to 4' ft., From 4' ft. to 0' ft., From _____ ft. to _____ ft.
 What is the nearest source of possible contamination:
 1 Septic tank 4 Lateral lines 7 Pit privy 11 Fuel storage 14 Abandoned water well
 2 Sewer lines 5 Cess pool 8 Sewage lagoon 12 Fertilizer storage 15 Oil well/Gas well
 3 Watertight sewer lines 6 Seepage pit 9 Feedyard 13 Insecticide storage 16 Other (specify below) _____
 Direction from well? West How many feet? 300'

FROM	TO	LITHOLOGIC LOG	FROM	TO	PLUGGING INTERVALS
0	1.50	Gravel, ls. 1x/10x, packed, dry			
1.50	3.50	Drk Brn clay, fine, dry, no odor			
3.50	7.50	lt Brn silty clay, oxide staining, no odor, dry to moist			
7.50	12.0	lt Brn silty clay w/ calciche stringers, moist, no odor, firm			
12.0	17.40	lt Brn silty, dirty clay, moist, soft, highly plastic, fine-med grained sand, no odor			
17.40	24.0	Tan-1/2 pale gray fine-coarse grained sand, poorly sorted, sub rounded, wet, no odor			
					FLUSH Mt. ok'd by Don Taylor

7 CONTRACTOR'S OR LANDOWNER'S CERTIFICATION: This water well was (1) constructed, (2) reconstructed, or (3) plugged under my jurisdiction and was completed on (mo/day/year) 1-3-97 and this record is true to the best of my knowledge and belief. Kansas Water Well Contractor's License No. 539 This Water Well Record was completed on (mo/day/yr) 1-8-97 under the business name of JB Environmental Drilling by (signature) James Becker

OFFICE USE ONLY T R EM SEC 1/4 1/4