

1 LOCATION OF WATER WELL: County: ROOKS Fraction: SW 1/4 SW 1/4 SW 1/4 Section Number: 35 Township Number: T 95 S Range Number: R 18 E


Distance and direction from nearest town or city street address of well if located within city?

MW 8

2 WATER WELL OWNER: DUCAN OIL  
 RR#, St. Address, Box #: 601 South Washington  
 City, State, ZIP Code: Plainville KS 67663  
 Board of Agriculture, Division of Water Resources  
 Application Number:

3 LOCATE WELL'S LOCATION WITH AN "X" IN SECTION BOX:

4 DEPTH OF COMPLETED WELL: 30 ft. ELEVATION:

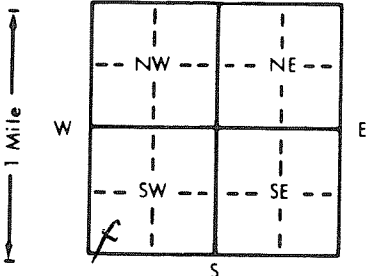

Depth(s) Groundwater Encountered 1. . . . . ft. 2. . . . . ft. 3. . . . . ft.  
 WELL'S STATIC WATER LEVEL . . . . . ft. below land surface measured on mo/day/yr  
 Pump test data: Well water was . . . . . ft. after . . . . . hours pumping . . . . . gpm  
 Est. Yield . . . . . gpm: Well water was . . . . . ft. after . . . . . hours pumping . . . . . gpm  
 Bore Hole Diameter: 8 in. to 30 ft., and . . . . . in. to . . . . . ft.  
 WELL WATER TO BE USED AS:  
 1 Domestic 3 Feedlot 6 Oil field water supply 9 Dewatering 12 Other (Specify below)  
 2 Irrigation 4 Industrial 7 Lawn and garden only 10 Monitoring well  
 Was a chemical/bacteriological sample submitted to Department? Yes . . . . . No X . . . . . ; If yes, mo/day/yr sample was submitted  
 Water Well Disinfected? Yes X No

5 TYPE OF BLANK CASING USED:  
 Steel 3 RMP (SR) 5 Wrought iron 8 Concrete tile CASING JOINTS: Glued . . . . . Clamped . . . . .  
 PVC 4 ABS 6 Asbestos-Cement 9 Other (specify below) Welded . . . . .  
 7 Fiberglass Threaded X  
 Blank casing diameter . . . . . in. to 15 ft., Dia . . . . . in. to . . . . . ft., Dia . . . . . in. to . . . . . ft.  
 Casing height above land surface . . . . . in., weight . . . . . lbs./ft. Wall thickness or gauge No. SCH 40

TYPE OF SCREEN OR PERFORATION MATERIAL:  
 Steel 3 Stainless steel 5 Fiberglass 8 RMP (SR) 10 Asbestos-cement  
 Brass 4 Galvanized steel 6 Concrete tile 9 ABS 11 Other (specify) . . . . .  
 PVC 12 None used (open hole)

SCREEN OR PERFORATION OPENINGS ARE:  
 1 Continuous slot 3 Mill slot 5 Gauzed wrapped  Saw cut 11 None (open hole)  
 2 Louvered shutter 4 Key punched 6 Wire wrapped 9 Drilled holes  
 7 Torch cut 10 Other (specify) . . . . .

SCREEN-PERFORATED INTERVALS: From 15 ft. to 30 ft., From . . . . . ft. to . . . . . ft.  
 GRAVEL PACK INTERVALS: From 14 ft. to 30 ft., From . . . . . ft. to . . . . . ft.

6 GROUT MATERIAL: 1 Neat cement 2 Cement grout 3 Bentonite 4 Other  
 Grout Intervals: From 0 ft. to 1 ft., From 1 ft. to 4 ft., From . . . . . ft. to . . . . . ft.

What is the nearest source of possible contamination:  
 1 Septic tank 4 Lateral lines 7 Pit privy 10 Livestock pens 14 Abandoned water well  
 2 Sewer lines 5 Cess pool 8 Sewage lagoon 11 Fuel storage 15 Oil well/Gas well  
 3 Watertight sewer lines 6 Seepage pit 9 Feedyard 12 Fertilizer storage 16 Other (specify below)  
 13 Insecticide storage

Direction from well? How many feet?

FROM	TO	LITHOLOGIC LOG	FROM	TO	PLUGGING INTERVALS
<u>0</u>	<u>5</u>	<u>med gray clay</u>			
<u>5</u>	<u>26</u>	<u>reddish brown silty clay</u>			
<u>26</u>	<u>30</u>	<u>gray silty sand</u>			

7 CONTRACTOR'S OR LANDOWNER'S CERTIFICATION: This water well was  constructed, (2) reconstructed, or (3) plugged under my jurisdiction and was completed on (mo/day/year) 1/9/97 and this record is true to the best of my knowledge and belief. Kansas Water Well Contractor's License No. 554 This Water Well Record was completed on (mo/day/yr) 3/25/97 under the business name of AG Services by (signature) Bill Davis

OFFICE USE ONLY  
T  
R  
E  
M  
S  
E  
C  
1/4  
1/4  
1/4