


1 LOCATION OF WATER WELL: County: ROCKS Fraction: NW 1/4 SE 1/4 SW 1/4 Section Number: 35 Township Number: T 9 S Range Number: R 18 E/W

Distance and direction from nearest town or city street address of well if located within city?

2 WATER WELL OWNER: KDHE
 RR#, St. Address, Box #: Jorbes Field, Bldg 740
 City, State, ZIP Code: Topeka, KS 66620-0001 MW 5A
 Board of Agriculture, Division of Water Resources
 Application Number:

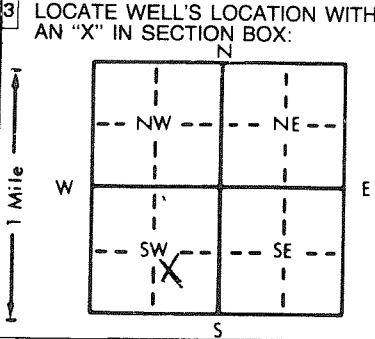

4 DEPTH OF COMPLETED WELL: 56 ft. ELEVATION: _____

Depth(s) Groundwater Encountered 1. _____ ft. 2. _____ ft. 3. _____ ft.

WELL'S STATIC WATER LEVEL: 25.26 ft. below land surface measured on mo/day/yr

Pump test data: Well water was _____ ft. after _____ hours pumping _____ gpm

Est. Yield _____ gpm: Well water was _____ ft. after _____ hours pumping _____ gpm

Bore Hole Diameter: 8 in. to 56 ft., and _____ in. to _____ ft.

WELL WATER TO BE USED AS:

5 Public water supply	8 Air conditioning	11 Injection well
1 Domestic	3 Feedlot	6 Oil field water supply
2 Irrigation	4 Industrial	7 Lawn and garden only
		10 <u>Monitoring well</u>

12 Other (Specify below)

Was a chemical/bacteriological sample submitted to Department? Yes _____ No: X If yes, mo/day/yr sample was submitted _____

Water Well Disinfected? Yes _____ No: X

5 TYPE OF BLANK CASING USED:

1 Steel	3 RMP (SR)	5 Wrought iron	8 Concrete tile
2 <u>PVC</u>	4 <u>ABS</u>	6 Asbestos-Cement	9 Other (specify below)
		7 Fiberglass	

CASING JOINTS: Glued _____ Clamped _____
 Welded _____
 Threaded: X

Blank casing diameter: 2 in. to 41 ft., Dia _____ in. to _____ ft., Dia _____ in. to _____ ft.

Casing height above land surface: _____ in., weight _____ lbs./ft. Wall thickness or gauge No. 154

TYPE OF SCREEN OR PERFORATION MATERIAL:

1 Steel	3 Stainless steel	5 Fiberglass	7 <u>PVC</u>	10 Asbestos-cement
2 Brass	4 Galvanized steel	6 Concrete tile	8 RMP (SR)	11 Other (specify)
			9 ABS	12 None used (open hole)

SCREEN OR PERFORATION OPENINGS ARE:

1 Continuous slot	3 Mill slot	5 Gauzed wrapped	8 <u>Saw cut</u>	11 None (open hole)
2 Louvered shutter	4 Key punched	6 Wire wrapped	9 Drilled holes	
		7 Torch cut	10 Other (specify)	

SCREEN-PERFORATED INTERVALS: From 71 ft. to 56 ft., From _____ ft. to _____ ft.

GRAVEL PACK INTERVALS: From 39 ft. to 56 ft., From _____ ft. to _____ ft.

6 GROUT MATERIAL: 1 Neat cement 2 Cement grout 3 Bentonite 4 Other _____

Grout Intervals: From 0 ft. to 2 ft., From 2 ft. to 39 ft., From _____ ft. to _____ ft.

What is the nearest source of possible contamination:

1 Septic tank	4 Lateral lines	7 Pit privy	10 Livestock pens	14 Abandoned water well
2 Sewer lines	5 Cess pool	8 Sewage lagoon	11 Fuel storage	15 Oil well/Gas well
3 Watertight sewer lines	6 Seepage pit	9 Feedyard	12 Fertilizer storage	16 Other (specify below)
			13 Insecticide storage	<u>Contaminated site</u>

Direction from well? How many feet?

FROM	TO	LITHOLOGIC/LOG	FROM	TO	PLUGGING INTERVALS
0	10	Sandy clay w/trace caliche			
10	15	Silty clay			
15	28	sandy silty clay			
28	56	Silty sand			

7 CONTRACTOR'S OR LANDOWNER'S CERTIFICATION: This water well was (1) constructed, (2) reconstructed, or (3) plugged under my jurisdiction and was completed on (mo/day/year) 10-13-97 and this record is true to the best of my knowledge and belief. Kansas Water Well Contractor's License No. 554 This Water Well Record was completed on (mo/day/yr) 11-20-97 under the business name of Woolter Pump & W by (signature) Ray C. Woolter

OFFICE USE ONLY
T
R
EW
SEC.
1/4
1/4
1/4