


1 LOCATION OF WATER WELL: Fraction	Section Number	Township Number	Range Number
County: <b>Rooks</b> SW 1/4 SE 1/4 SW 1/4	<b>26</b>	<b>09</b>	<b>18 W</b>
Distance and direction from nearest town or city street address of well if located within city? <b>300 NW 3<sup>rd</sup> Street</b>			

2 WATER WELL OWNER: **John Ruder**  
 RR#, St. Address, Box # **300 NW 3<sup>rd</sup> St.**  
 City, State, ZIP Code : **Plainville, KS 67663**  
 Board of Agriculture, Division of Water Resources  
 Application Number:

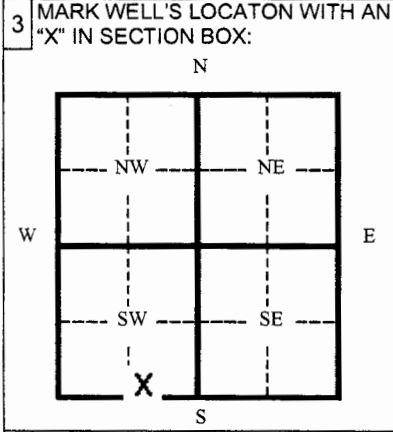

4 DEPTH OF WELL **34.5** ft.  
 WELL'S STATIC WATER LEVEL \_\_\_\_\_ ft.  
 WELL WAS USED AS:  
 1 Domestic                      5 Public Water Supply                      9 Dewatering  
 2 Irrigation                      6 Oil Field Water Supply                      **10 Monitoring Well**  
 3 Feedlot                          7 Lawn and Garden (domestic)                      11 Injection Well  
 4 Industrial                      8 Air Conditioning                          12 Other \_\_\_\_\_  
 Was a chemical/bacteriological sample submitted to Department? Yes \_\_\_\_\_ No **X**  
 If yes, mo/day/yr sample was submitted \_\_\_\_\_  
 Water Well Disinfected: Yes \_\_\_\_\_ No **X**

5 TYPE OF BLANK CASING USED:  
 1 Steel                      3 RMP (SR)                      5 Wrought                      7 Fiberglass                      9 Other (specify below)  
**2 PVC**                      4 ABC                      6 Asbestos-Cement                      8 Concrete Tile  
 Blank casing diameter **2** in. Was casing pulled? Yes \_\_\_\_\_ No **X** If yes, how much \_\_\_\_\_  
 Casing height above or below land surface **240** in. **Overdrilled 20 ft. below ground surface**

6 GROUT PLUG MATERIAL: 1 Neat cement    2 Cement grout    **3 Bentonite**    4 Other \_\_\_\_\_  
 Grout Plug Intervals From **3** ft. to **20** ft. From \_\_\_\_\_ ft. to \_\_\_\_\_ ft. From \_\_\_\_\_ ft. to \_\_\_\_\_ ft.  
 What is the nearest source of possible contamination:  
 1 Septic tank                      6 Seepage pit                      11 Fuel storage                      16 Other (specify below)  
 2 Sewer lines                      7 Pit privy                          12 Fertilizer storage  
 3 Watertight sewer lines                      8 Sewage lagoon                      13 Insecticide storage  
 4 Lateral lines                      9 Feedyard                          14 Abandoned water well  
 5 Cess Pool                          10 Livestock pens                      15 Oil well/ Gas well  
 Direction from well? \_\_\_\_\_ How many feet? \_\_\_\_\_

FROM	TO	CODE	PLUGGING MATERIALS
<b>0</b>	<b>3</b>		<b>Soil</b>
<b>3</b>	<b>20</b>		<b>Bentonite</b>

RECEIVED  
 SEP 13 2004  
 BUREAU OF WATER

7 CONTRACTOR'S OR LANDOWNER'S CERTIFICATION: This water well was plugged under my jurisdiction and was completed on (mo/day/yr) **6-9-04** and this record is true to the best of my knowledge and belief. Kansas Water Well Contractor's License No. **531** This Water Well Record was completed on (mo/day/yr) **6-22-04** under the business name of **Geotechnical Services, Inc.**  
 by (signature) *Alison M. [Signature]*

INSTRUCTIONS: Please fill in blanks and circle the correct answers. Send three copies to Kansas Department of Health and Environment, Bureau of Water, 1000 S W Jackson St., Ste. 420, Topeka, Kansas 66620-0001. Telephone: 785-296-3565. Send one to Water Well Owner and retain one for your records.