


C-30

WATER WELL RECORD Form WWC-5 KSA 82a-1212

1 LOCATION OF WATER WELL: Fraction SW 1/4 NW 1/4 SW 1/4 Section Number 35 Township Number T 9 S Range Number R 18 ESW

Distance and direction from nearest town or city street address of well if located within city? APPROXIMATELY 252' E. of Section Line Rd, Approximately 10' South of S. 10th St.

2 WATER WELL OWNER: Union Pacific Railroad RR#, St. Address, Box #: 1400 Douglas St. STOP 1030 City, State, ZIP Code: Omaha, NE 68179-1030 Board of Agriculture, Division of Water Resources Application Number:

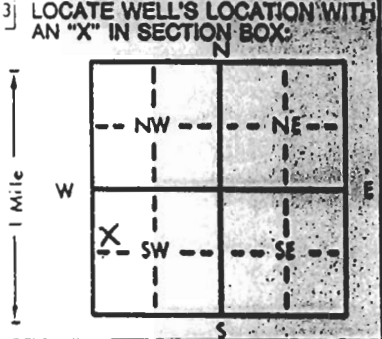

4 DEPTH OF COMPLETED WELL: 54.40 ft. ELEVATION: ... ft.

Depth(s) Groundwater Encountered 1. ... ft. 2. ... ft. 3. ... ft.

WELL'S STATIC WATER LEVEL: 23.50 ft. below land surface measured on mo/day/yr

Pump test data: Well water was ... ft. after ... hours pumping ... gpm

Est. Yield ... gpm: Well water was ... ft. after ... hours pumping ... gpm

Bore Hole Diameter: 3-25 in. to 5.5 in. to ... in. to ... in.

WELL WATER TO BE USED AS:

1 Domestic	3 Feedlot	6 Oil field water supply	9 Dewatering
2 Irrigation	4 Industrial	7 Lawn and garden only	10 Monitoring well
5 Public water supply	8 Air conditioning	11 Injection well	12 Other (Specify below)

Was a chemical/bacteriological sample submitted to Department? Yes.....No.; If yes, mo/day/yr sample was submitted

Water Well Disinfected? Yes No

5 TYPE OF BLANK CASING USED:

1 Steel	3 RMP (SR)	5 Wrought iron	8 Concrete tile	CASING JOINTS: Glued ... Clamped ...
2 PVC	4 ABS	6 Asbestos-Cement	9 Other (specify below)	Welded ...
		7 Fiberglass		Threaded ...

Blank casing diameter ... in. to ... ft. Dia ... in. to ... ft. Dia ... in. to ... ft.

Casing height above land surface ... in. weight ... lbs./ft. Wall thickness or gauge No. ...

TYPE OF SCREEN OR PERFORATION MATERIAL:

1 Steel	3 Stainless steel	5 Fiberglass	8 RMP (SR)	10 Asbestos-cement
2 Brass	4 Galvanized steel	6 Concrete tile	9 ABS	11 Other (specify) ...
				12 None used (open hole)

SCREEN OR PERFORATION OPENINGS ARE:

1 Continuous slot	3 Mill slot	5 Gauzed wrapped	8 Saw cut	11 None (open hole)
2 Louvered shutter	4 Key punched	6 Wire wrapped	9 Drilled holes	
		7 Torch cut	10 Other (specify) ...	

SCREEN-PERFORATED INTERVALS: From 44.40 ft. to 54.40 ft. From ... ft. to ... ft.

GRAVEL PACK INTERVALS: From 42 ft. to 54.40 ft. From ... ft. to ... ft.

3 GROUT MATERIAL: 1 Neat cement 2 Cement grout 3 Bentonite 4 Other

Grout intervals: From D.S. ft. to 42 ft. From ... ft. to ... ft.

What is the nearest source of possible contamination:

1 Septic tank	4 Lateral lines	7 Pit privy	10 Livestock pens	14 Abandoned water well
2 Sewer lines	5 Cess pool	8 Sewage lagoon	11 Fuel storage	15 Oil well/Gas well
3 Watertight sewer lines	6 Seepage pit	9 Feedyard	12 Fertilizer storage	16 Other (specify below)
			13 Insecticide storage	

Direction from well? N How many feet?

FROM	TO	LITHOLOGIC LOG	FROM	TO	PLUGGING INTERVALS
1	50	silt w/caliche stringers			
50	54.40	Silty Sand			

7 CONTRACTOR'S OR LANDOWNER'S CERTIFICATION: This water well was (1) constructed, (2) reconstructed, or (3) plugged under my jurisdiction and was completed on (mo/day/year) 12/21/04 and this record is true to the best of my knowledge and belief. Kansas Water Well Contractor's License No. 604 This Water Well Record was completed on (mo/day/yr) 1/13/05 under the business name of Environmental Priority Sv., Inc. by (signature) Ptl & mt