

C-8D


WATER WELL RECORD Form WWC-5 KSA 82a-1212

1 LOCATION OF WATER WELL: Fraction NE 1/4 NW 1/4 SW 1/4 Section Number 35 Township Number T 9 S Range Number R 18 E/W

Distance and direction from nearest town or city street address of well if located within city?
Intersection of Madison & S. 7th St.; SE corner of intersect 10' south of 7th St.

2 WATER WELL OWNER: Union Pacific Railroad
RR#, St. Address, Box #: 1400 Douglas St. STOP 1030 Board of Agriculture, Division of Water Resources
City, State, ZIP Code: Omaha NE 68179-1030 Application Number:

3 LOCATE WELL'S LOCATION WITH AN "X" IN SECTION BOX:

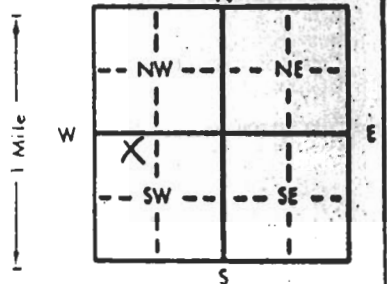

4 DEPTH OF COMPLETED WELL: 55.60 ft. ELEVATION:

Depth(s) Groundwater Encountered 1. ft. 2. ft. 3. ft.
WELL'S STATIC WATER LEVEL: 35.82 ft. below land surface measured on mo/day/yr
Pump test data: Well water was ft. after hours pumping gpm
Est. Yield gpm: Well water was ft. after hours pumping gpm
Bore Hole Diameter, 3.25 in. to 5.560 in., and in. to ft.
WELL WATER TO BE USED AS:
5 Public water supply 8 Air conditioning 11 Injection well
1 Domestic 3 Feedlot 6 Oil field water supply 9 Dewatering 12 Other (Specify below)
2 Irrigation 4 Industrial 7 Lawn and garden only 10 Monitoring well
Was a chemical/bacteriological sample submitted to Department? Yes.....No..X.....; If yes, mo/day/yr sample was submitted
Water Well Disinfected? Yes No

5 TYPE OF BLANK CASING USED:
1 Steel 3 RMP (SR) 5 Wrought iron 8 Concrete tile CASING JOINTS: Glued Clamped
2 PVC 4 ABS 6 Asbestos-Cement 9 Other (specify below) Welded
7 Fiberglass Threaded

Blank casing diameter 0.75 in. to ft., Dia in. to ft., Dia in. to ft.
Casing height above land surface 5 in., weight lbs./ft. Wall thickness or gauge No.
TYPE OF SCREEN OR PERFORATION MATERIAL:
1 Steel 3 Stainless steel 5 Fiberglass 8 RMP (SR) 10 Asbestos-cement
2 Brass 4 Galvanized steel 6 Concrete tile 9 ABS 11 Other (specify)
12 None used (open hole)
SCREEN OR PERFORATION OPENINGS ARE:
1 Continuous slot 3 Mill slot 5 Gauzed wrapped 8 Saw cut 11 None (open hole)
2 Louvered shutter 4 Key punched 6 Wire wrapped 9 Drilled holes
7 Torch cut 10 Other (specify)

SCREEN-PERFORATED INTERVALS: From 45.60 ft. to 55.60 ft., From ft. to ft.
GRAVEL PACK INTERVALS: From 4.3 ft. to 55.60 ft., From ft. to ft.

6 GROUT MATERIAL: 1 Neat cement 2 Cement grout 3 Bentonite 4 Other
Grout intervals: From 0.5 ft. to 4.3 ft., From ft. to ft.

What is the nearest source of possible contamination:
1 Septic tank 4 Lateral lines 7 Pit privy 10 Livestock pens 14 Abandoned water well
2 Sewer lines 5 Cess pool 8 Sewage lagoon 11 Fuel storage 15 Oil well/Gas well
3 Watertight sewer lines 6 Seepage pit 9 Feedyard 12 Fertilizer storage 16 Other (specify below)
13 Insecticide storage
Direction from well? NW How many feet?

FROM		TO		LITHOLOGIC LOG	FROM		TO		PLUGGING INTERVALS
1	50	50	55.60	Silt w/ caliche stringers					
50	55.60			Sandy silt					

7 CONTRACTOR'S OR LANDOWNER'S CERTIFICATION: This water well was (1) constructed, (2) reconstructed, or (3) plugged under my jurisdiction and was completed on (mo/day/year) 12/20/04 and this record is true to the best of my knowledge and belief. Kansas Water Well Contractor's License No. 6004 This Water Well Record was completed on (mo/day/yr) 1/13/05 under the business name of Environmental Priority Sv. Inc. by (signature) PTL smt

INSTRUCTIONS: Use typewriter or ball point pen. PLEASE PRESS FIRMLY and PRINT clearly. Please fill in blanks, underline or circle the correct answers. Send top three copies to Kansas Department of Health and Environment, Bureau of Water, Topeka, Kansas 66620-0001. Telephone: 813-296-5545. Send one to WATER WELL OWNER and retain one for your records.