


1 LOCATION OF WATER WELL: County: ROOKS Fraction: NE 1/4 NW 1/4 NW 1/4 Section Number: 34 Township Number: T 9 S Range Number: R 19 EW

Distance and direction from nearest town or city street address of well if located within city?
310 E. Plainville, Zurich, KS

2 WATER WELL OWNER: Don Dopita
 RR#, St. Address, Box #: 310 E. Plainville Board of Agriculture, Division of Water Resources
 City, State, ZIP Code: Zurich, KS 67674 Application Number:

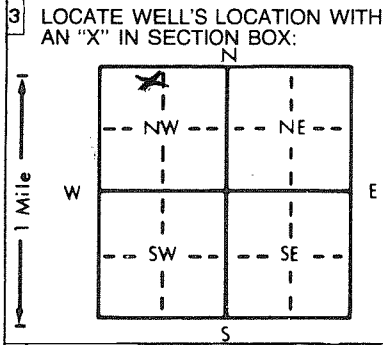

4 DEPTH OF COMPLETED WELL: 90 ft. ELEVATION: N/A
 Depth(s) Groundwater Encountered 1. 43-82 ft. 2. _____ ft. 3. _____ ft.
 WELL'S STATIC WATER LEVEL 40 ft. below land surface measured on mo/day/yr 9-20-97
 Pump test data: Well water was 41 ft. after 2 hours pumping 15 gpm
 Est. Yield 50+ gpm: Well water was _____ ft. after _____ hours pumping _____ gpm
 Bore Hole Diameter: 10 in. to T.O. ft., and _____ in. to _____ ft.
 WELL WATER TO BE USED AS:
 Domestic 3 Feedlot 6 Oil field water supply 9 Dewatering 12 Other (Specify below)
 2 Irrigation 4 Industrial 7 Lawn and garden only 10 Monitoring well
 Was a chemical/bacteriological sample submitted to Department? Yes _____ No If yes, mo/day/yr sample was submitted _____
 Water Well Disinfected? Yes No

5 TYPE OF BLANK CASING USED:
 1 Steel 3 RMP (SR) 6 Asbestos-Cement 9 Other (specify below) Welded
 2 PVC 4 ABS 7 Fiberglass _____ Threaded
 Blank casing diameter: 5 in. to 45 ft., Dia _____ in. to _____ ft., Dia _____ in. to _____ ft.
 Casing height above land surface: 18 in., weight _____ lbs./ft. Wall thickness or gauge No. SDR 26
 TYPE OF SCREEN OR PERFORATION MATERIAL:
 1 Steel 3 Stainless steel 5 Fiberglass 7 PVC 10 Asbestos-cement
 2 Brass 4 Galvanized steel 6 Concrete tile 8 RMP (SR) 11 Other (specify) _____
 9 ABS 12 None used (open hole)
 SCREEN OR PERFORATION OPENINGS ARE:
 1 Continuous slot 3 Mill slot 5 Gauzed wrapped 8 Saw cut 11 None (open hole)
 2 Louvered shutter 4 Key punched 6 Wire wrapped 9 Drilled holes
 7 Torch cut 10 Other (specify) _____
 SCREEN-PERFORATED INTERVALS: From 45 ft. to 90 ft., From _____ ft. to _____ ft.
 GRAVEL PACK INTERVALS: From 90 ft. to 20 ft., From _____ ft. to _____ ft.

6 GROUT MATERIAL: 1 Neat cement 2 Cement grout 3 Bentonite 4 Other _____
 Grout Intervals: From 20 ft. to 0 ft., From _____ ft. to _____ ft.
 What is the nearest source of possible contamination:
 1 Septic tank 4 Lateral lines 7 Pit privy 10 Livestock pens 14 Abandoned water well
 2 Sewer lines 5 Cess pool 8 Sewage lagoon 11 Fuel storage 15 Oil well/Gas well
 3 Watertight sewer lines 6 Seepage pit 9 Feedyard 12 Fertilizer storage 16 Other (specify below)
 13 Insecticide storage
 Direction from well? SW How many feet? 75 ft.

FROM	TO	LITHOLOGIC LOG	FROM	TO	PLUGGING INTERVALS
0	5	Loess			
5	7	Lt. brn. Clay			
12	20	v.f. grn. silt			
20	43	brn. clay			
43	82	F. grn. to med. grn. Sand			
82	86	wt. gel. clay			
86	87	Weathered Shale br-grn.			
87	90	Hard non-fissile br-grn. shale			

7 CONTRACTOR'S OR LANDOWNER'S CERTIFICATION: This water well was (1) constructed, (2) reconstructed, or (3) plugged under my jurisdiction and was completed on (mo/day/year) 9-20-97 and this record is true to the best of my knowledge and belief. Kansas Water Well Contractor's License No. 608 This Water Well Record was completed on (mo/day/yr) 11-3-97 under the business name of Yellow Jacket Drilling by signature [Signature]

OFFICE USE ONLY
T
R
EW
SEC.
1/4
1/4
1/4