


WATER WELL PLUGGING RECORD Form WWC-5P

KSA 82a-1212 ID NO. MW3

1 LOCATION OF WATER WELL: County: <u>Rooks</u>	Fraction <u>NW 1/4 NW 1/4 NE 1/4 NW 1/4</u>	Section Number <u>35</u>	Township Number <u>9 S</u>	Range Number <u>18</u> <input type="checkbox"/> E <input checked="" type="checkbox"/> W
--	--	-----------------------------	-------------------------------	--

Street/Rural Address of Well Location; if unknown, distance and direction from nearest town or intersection. If at owner's address, check here <input type="checkbox"/> <u>401 W. Mill St., Plainville</u>	Global Positioning Systems (GPS) Information: Latitude: <u>39.23403</u> (in decimal degrees) Longitude: <u>-99.30294</u> (in decimal degrees) Elevation: <u>2148.42</u> Datum: <input checked="" type="checkbox"/> WGS84 <input type="checkbox"/> NAD83 <input type="checkbox"/> NAD27 Collection Method: <input type="checkbox"/> GPS unit Make/Model: _____ <input type="checkbox"/> Digital Map/Photo <input type="checkbox"/> Topographic Map <input checked="" type="checkbox"/> Land Survey Est. Accuracy: <input type="checkbox"/> <3 m <input type="checkbox"/> 3-5 m <input type="checkbox"/> 5-15 m <input type="checkbox"/> >15 m
---	---

2 WATER WELL OWNER: <u>KDHE</u> RR#, St. Address, Box # <u>1000 SW Jackson St.</u> City, State ZIP Code <u>Topeka, KS 66612</u>	
--	--

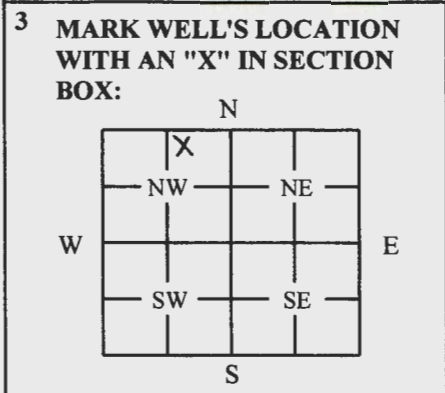

4 DEPTH OF WELL: 30.09 ft.
WELL'S STATIC WATER LEVEL: 19.45 ft. BTOC
WELL WAS USED AS:
 Domestic Public Water Supply Dewatering
 Irrigation Old Field Water Supply Monitoring
 Feedlot Domestic (Lawn/Garden) Injection Well
 Industrial Air Conditioning Other _____
 Was a chemical/bacteriological sample submitted to Department? Yes No

5 TYPE OF BLANK CASING USED:
 Steel RMP (SR) Wrought Fiberglass Other:
 PVC ABS Asbestos/Cement Concrete Tile _____
 Blank casing diameter: 2 in. Was casing pulled? Yes No If Yes, how much 3'
 Casing height above or below land surface: 0 in.

6 GROUT PLUG MATERIAL: Neat cement Cement grout Bentonite Other: _____
 Grout Plug Intervals: From 3 ft. To 30.09 ft. From _____ ft. To _____ ft. From _____ ft. To _____ ft.
 What is the nearest source of possible contamination:
 Septic tank Seepage pit Fuel storage Other (specify below): _____
 Sewer lines Pit privy Fertilizer storage _____
 Watertight sewer lines Sewage lagoon Insecticide storage _____
 Lateral lines Feedyard Abandoned water well _____
 Cess pool Livestock pens Oil well/Gas well _____
 Direction from well: NE
 How many feet: ~75

FROM	TO	PLUGGING MATERIAL	FROM	TO	PLUGGING MATERIAL
0	3	Native soil			
3	30.09	Bentonite			
					MW3
					KDHE Project #U6-082-14362

7 CONTRACTOR'S OR LANDOWNER'S CERTIFICATION: This water well was plugged under my jurisdiction and was completed on (mo/day/year) 7/12/2022 and this record is true to the best of my knowledge and belief. Kansas Water Well Contractor's License No. 527. This Water Well Record was completed on (mo/day/year) 7/13/2022 under the business name of GeoCore, LLC by (signature) Dale Kell.

INSTRUCTIONS: Use typewriter or ballpoint pen. Please press firmly and print clearly. Please fill in blanks, underline or circle the correct answers. Send one copy to Kansas Department of Health and Environment, Bureau of Water, Geology Section, 1000 SW Jackson St., Ste. 420, Topeka, Kansas 66612-1367. Telephone 785/296-5524. Send one to Water Well Owner and retain one for your records. Visit us at <http://www.kdheks.gov/waterwell/index.html>.