


1] LOCATION OF WATER WELL: Fraction SW 1/4 SE 1/4 SW 1/4 Section Number 26 Township Number T 9 S Range Number R 18 EW  
 County: ROOKS

Distance and direction from nearest town or city street address of well if located within city?  
300 NW 3rd St.

2] WATER WELL OWNER: John Ruder  
 RR#, St. Address, Box #: 300NW 3rd St. Board of Agriculture, Division of Water Resources  
 City, State, ZIP Code: Plainville, KS 67663 Application Number:

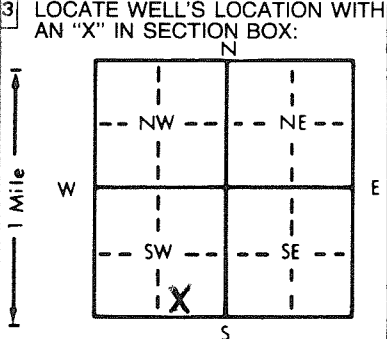

4] DEPTH OF COMPLETED WELL: 34.5 ft. ELEVATION:  
 Depth(s) Groundwater Encountered 1. 28.0 ft. 2. ft. 3. ft.  
 WELL'S STATIC WATER LEVEL 26.24 ft. below land surface measured on mo/day/yr 2/19/93  
 Pump test data: Well water was ft. after hours pumping gpm  
 Est. Yield gpm: Well water was ft. after hours pumping gpm  
 Bore Hole Diameter: 8 in. to ft., and in. to ft.  
 WELL WATER TO BE USED AS:  
 5 Public water supply 8 Air conditioning 11 Injection well  
 1 Domestic 3 Feedlot 6 Oil field water supply 9 Dewatering 12 Other (Specify below)  
 2 Irrigation 4 Industrial 7 Lawn and garden only 0 Monitoring well  
 Was a chemical/bacteriological sample submitted to Department? Yes.....No. X.....; If yes, mo/day/yr sample was submitted  
 Water Well Disinfected? Yes No X

5] TYPE OF BLANK CASING USED:  
 1 Steel 3 RMP (SR) 5 Wrought iron 8 Concrete tile CASING JOINTS: Glued.....Clamped.....  
2 PVC 4 ABS 6 Asbestos-Cement 9 Other (specify below) Welded.....  
 7 Fiberglass Threaded FLUSH  
 Blank casing diameter 2 in. to ft., Dia. in. to ft., Dia. in. to ft.  
 Casing height above land surface: FLUSH in., weight 703 lbs./ft. Wall thickness or gauge No. 154  
 TYPE OF SCREEN OR PERFORATION MATERIAL:  
 1 Steel 3 Stainless steel 5 Fiberglass 8 RMP (SR) 10 Asbestos-cement  
 2 Brass 4 Galvanized steel 6 Concrete tile 9 ABS 11 Other (specify)  
 SCREEN OR PERFORATION OPENINGS ARE:  
 1 Continuous slot 3 Mill slot 5 Gauzed wrapped 8 Saw cut 11 None (open hole)  
 2 Louvered shutter 4 Key punched 6 Wire wrapped 9 Drilled holes  
 7 Torch cut 10 Other (specify)  
 SCREEN-PERFORATED INTERVALS: From 19.5 ft. to 34.5 ft., From ft. to ft.  
 From ft. to ft., From ft. to ft.  
 GRAVEL PACK INTERVALS: From 18.5 ft. to 34.5 ft., From ft. to ft.  
 From ft. to ft., From ft. to ft.

6] GROUT MATERIAL: 1 Neat cement 2 Cement grout 3 Bentonite 4 Other  
 Grout Intervals: From 18.5 ft. to 1.0 ft., From ft. to ft., From ft. to ft.  
 What is the nearest source of possible contamination:  
 1 Septic tank 4 Lateral lines 7 Pit privy 10 Livestock pens 14 Abandoned water well  
 2 Sewer lines 5 Cess pool 8 Sewage lagoon 11 Fuel storage 15 Oil well/Gas well  
 3 Watertight sewer lines 6 Seepage pit 9 Feedyard 12 Fertilizer storage 16 Other (specify below)  
 13 Insecticide storage  
 Direction from well? SE How many feet? 40'

FROM	TO	LITHOLOGIC LOG	FROM	TO	PLUGGING INTERVALS
0.0	8.5	CLAY			
8.5	11.5	CLAY, SILTY			
11.5	13.5	Sand, fine-very fine grain, poorly sorted			
13.5	18.5	Clay, silty			
18.5	23.5	Sandy clay			
23.5	28.5	Sandy clay			
28.5	33.5	Sand, fine grain, well-mod sorted			
33.5	34.5	Sand, very fine-med grain, poorly sorted			
Flush mount waiver granted 12-17-92 for Ruder Oil Co.; KDHE 06082368 by Don Taylor					

7] CONTRACTOR'S OR LANDOWNER'S CERTIFICATION: This water well was 1 constructed, (2) reconstructed, or (3) plugged under my jurisdiction and was completed on (mo/day/year) 2-9-93 and this record is true to the best of my knowledge and belief. Kansas Water Well Contractor's License No. 531 This Water Well Record was completed on (mo/day/yr) 2-15-93 under the business name of GSI by (signature) Allison Irwin