


1 LOCATION OF WATER WELL: Fraction SW 1/4 SE 1/4 SW 1/4 Section Number 26 Township Number T 9 S Range Number R 18 E/W
 County: ROOKS

Distance and direction from nearest town or city street address of well if located within city?
300 NW 3rd St.

2 WATER WELL OWNER: John Ruder
 RR#, St. Address, Box #: 300 NW 3rd St. Board of Agriculture, Division of Water Resources
 City, State, ZIP Code: Plainville KS 67663 Application Number:

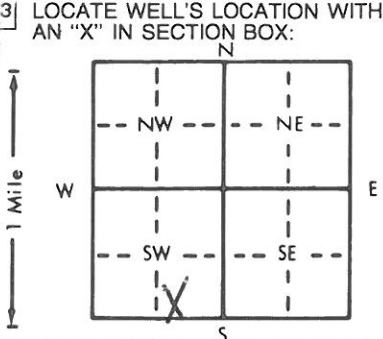

4 DEPTH OF COMPLETED WELL: 34.5 ft. ELEVATION:
 Depth(s) Groundwater Encountered 1. 27.5 ft. 2. ft. 3. ft.
 WELL'S STATIC WATER LEVEL 26.5 ft. below land surface measured on mo/day/yr 2-9-93
 Pump test data: Well water was ft. after hours pumping gpm
 Est. Yield gpm; Well water was ft. after hours pumping gpm
 Bore Hole Diameter 8 in. to ft., and in. to ft.
 WELL WATER TO BE USED AS:
 1 Domestic 3 Feedlot 6 Oil field water supply 9 Dewatering 11 Injection well
 2 Irrigation 4 Industrial 7 Lawn and garden only 10 Monitoring well 12 Other (Specify below)
 Was a chemical/bacteriological sample submitted to Department? Yes.....No X.....; If yes, mo/day/yr sample was submitted
 Water Well Disinfected? Yes No X

5 TYPE OF BLANK CASING USED:
 1 Steel 3 RMP (SR) 5 Wrought iron 8 Concrete tile CASING JOINTS: Glued.....Clamped.....
2 PVC 4 ABS 6 Asbestos-Cement 9 Other (specify below) Welded.....
 Blank casing diameter in. to ft., Dia in. to ft., Dia in. to ft., Dia in. to ft.
 Casing height above land surface Flush in., weight 703 lbs./ft. Wall thickness or gauge No. 15.4
 TYPE OF SCREEN OR PERFORATION MATERIAL:
 1 Steel 3 Stainless steel 5 Fiberglass 8 RMP (SR) 10 Asbestos-cement
 2 Brass 4 Galvanized steel 6 Concrete tile 9 ABS 11 Other (specify).....
 12 None used (open hole)
 SCREEN OR PERFORATION OPENINGS ARE:
 1 Continuous slot 3 Mill slot 5 Gauzed wrapped 8 Saw cut 11 None (open hole)
 2 Louvered shutter 4 Key punched 6 Wire wrapped 9 Drilled holes
 7 Torch cut 10 Other (specify).....
 SCREEN-PERFORATED INTERVALS: From 19.5 ft. to 34.5 ft., From ft. to ft., From ft. to ft., From ft. to ft.
 GRAVEL PACK INTERVALS: From 18.5 ft. to 34.5 ft., From ft. to ft., From ft. to ft., From ft. to ft.

6 GROUT MATERIAL: 1 Neat cement 2 Cement grout 3 Bentonite 4 Other.....
 Grout Intervals: From 18.5 ft. to 1.0 ft., From ft. to ft., From ft. to ft., From ft. to ft.
 What is the nearest source of possible contamination:
 1 Septic tank 4 Lateral lines 7 Pit privy 11 Fuel storage 14 Abandoned water well
 2 Sewer lines 5 Cess pool 8 Sewage lagoon 12 Fertilizer storage 15 Oil well/Gas well
 3 Watertight sewer lines 6 Seepage pit 9 Feedyard 13 Insecticide storage 16 Other (specify below)
 Direction from well? NW How many feet? 50'

FROM	TO	LITHOLOGIC LOG	FROM	TO	PLUGGING INTERVALS
0.0	8.5	Clay			
8.5	13.5	Clay, very slightly silty			
13.5	18.5	Clay, silty			
18.5	23.5	Sand, very fine to fine grain, poorly sorted			
23.5	28.5	Sand, fine to med grain, well to moderate sorted			
28.5	34.5	Sand, fine grain, well sorted			
Flush Mount waiver granted 12-17-92 for Rider Oil Co; KDHE 06082368 by Don Taylor					

7 CONTRACTOR'S OR LANDOWNER'S CERTIFICATION: This water well was (1) constructed, (2) reconstructed, or (3) plugged under my jurisdiction and was completed on (mo/day/year) 2-9-93 and this record is true to the best of my knowledge and belief. Kansas Water Well Contractor's License No. 531 This Water Well Record was completed on (mo/day/yr) 2-16-93 under the business name of GSI by (signature) Allison Irwin