


MWS

1 LOCATION OF WATER WELL: Fraction SW 1/4 SW 1/4 SE 1/4 Section Number 26 Township Number T 9 S Range Number R 13 EW  
 County: Hanks

Distance and direction from nearest town or city street address of well if located within city?  
102 N. Washington Plainville, Ks 67663

2 WATER WELL OWNER: Petrolean Mining  
 RR#, St. Address, Box # : 14201 S. Central  
 City, State, ZIP Code : Wichita, Ks 67230  
 Board of Agriculture, Division of Water Resources  
 Application Number:

3 LOCATE WELL'S LOCATION WITH AN "X" IN SECTION BOX: 4 DEPTH OF COMPLETED WELL: 22 ft. ELEVATION: 2142.12  
 Depth(s) Groundwater Encountered 1. 16 ft. 2. . ft. 3. . ft.  
 WELL'S STATIC WATER LEVEL 16 ft. below land surface measured on mo/day/yr

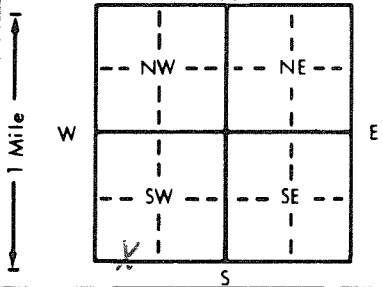

Pump test data: Well water was . ft. after . hours pumping . gpm  
 Est. Yield . gpm: Well water was . ft. after . hours pumping . gpm  
 Bore Hole Diameter 8 in. to 22 . ft., and . in. to . ft.  
 WELL WATER TO BE USED AS:  
 1 Domestic 3 Feedlot 6 Oil field water supply 9 Dewatering 12 Other (Specify below)  
 2 Irrigation 4 Industrial 7 Lawn and garden only 10 Monitoring well  
 Was a chemical/bacteriological sample submitted to Department? Yes . No .; If yes, mo/day/yr sample was submitted  
 Water Well Disinfected? Yes C No

5 TYPE OF BLANK CASING USED:  
 1 Steel 3 RMP (SR) 5 Wrought iron 8 Concrete tile CASING JOINTS: Glued . Clamped .  
 PVC 4 ABS 7 Fiberglass . . . . . Welded .  
 . . . . . Threaded.

Blank casing diameter 2 in. to 22 . ft., Dia . in. to . ft., Dia . in. to . ft.  
 Casing height above land surface -20 in., weight . lbs./ft. Wall thickness or gauge No. .

TYPE OF SCREEN OR PERFORATION MATERIAL:  
 1 Steel 3 Stainless steel 5 Fiberglass 8 RMP (SR) 10 Asbestos-cement  
 2 Brass 4 Galvanized steel 6 Concrete tile 9 ABS 11 Other (specify) .  
 12 None used (open hole)

SCREEN OR PERFORATION OPENINGS ARE:  
 1 Continuous slot 3 Mill slot 5 Gauzed wrapped 8 Saw cut 11 None (open hole)  
 2 Louvered shutter 4 Key punched 6 Wire wrapped 9 Drilled holes  
 7 Torch cut 10 Other (specify) .

SCREEN-PERFORATED INTERVALS: From 12 ft. to 22 . ft. From . ft. to . ft.  
 From . ft. to . ft. From . ft. to . ft.  
 GRAVEL PACK INTERVALS: From 10 ft. to 22 . ft. From . ft. to . ft.  
 From . ft. to . ft. From . ft. to . ft.

6 GROUT MATERIAL: 1 Neat cement  Cement grout  Bentonite 4 Other .  
 Grout Intervals: From 0 . ft. to 10 . ft., From . ft. to . ft., From . ft. to . ft.

What is the nearest source of possible contamination:  
 1 Septic tank 4 Lateral lines 7 Pit privy 10 Livestock pens 14 Abandoned water well  
 2 Sewer lines 5 Cess pool 8 Sewage lagoon 11 Fuel storage 15 Oil well/Gas well  
 3 Watertight sewer lines 6 Seepage pit 9 Feedyard 12 Fertilizer storage 16 Other (specify below)  
 13 Insecticide storage

Direction from well? N.W How many feet?

FROM	TO	LITHOLOGIC LOG	FROM	TO	PLUGGING INTERVALS
0	5	Organic rich silty clay block			
5	8	Mottled Ben silty clay			
8	12	Top to Ben Mottled Silt			
12	18	Mud to fine clean sand			
18	22	Mud to fine silty sand			

7 CONTRACTOR'S OR LANDOWNER'S CERTIFICATION: This water well was (1) constructed, (2) reconstructed, or (3) plugged under my jurisdiction and was completed on (mo/day/year) 04-13-94 and this record is true to the best of my knowledge and belief. Kansas Water Well Contractor's License No. 529 This Water Well Record was completed on (mo/day/yr) 04-19-94 under the business name of Geotechnical Inc by (signature) AT Baldwin