

1 LOCATION OF WATER WELL  
 County: Rooks Fraction: NW 1/4 NW 1/4 SE 1/4 Section Number: 35 Township Number: T 9 S Range Number: R 18 E/W  
 Distance and direction from nearest town or city? In Plainville Street address of well if located within city? 801 S. Commercial Avenue

2 WATER WELL OWNER: Gene Jaco  
 RR#, St. Address, Box #: 801 S. Commercial Avenue Board of Agriculture, Division of Water Resources  
 City, State, ZIP Code: Plainville, Kansas 67663 Application Number:

3 DEPTH OF COMPLETED WELL: 63 ft. Bore Hole Diameter: 12 in. to ... ft., and ... in. to ... ft.  
 Well Water to be used as:  
 1 Domestic 3 Feedlot 5 Public water supply 8 Air conditioning 11 Injection well  
 2 Irrigation 4 Industrial 6 Oil field water supply 9 Dewatering 12 Other (Specify below)  
7 Lawn and garden only 10 Observation well  
 Well's static water level: 40 ft. below land surface measured on July month 19 day 1980 year  
 Pump Test Data: Well water was 60 ft. after 2 hours pumping. 9 gpm  
 Est. Yield 9 gpm: Well water was ... ft. after ... hours pumping


4 TYPE OF BLANK CASING USED:  
 1 Steel 3 RMP (SR) 5 Wrought iron 8 Concrete tile Casing Joints:  Glued  Clamped  
 2 PVC 4 ABS 6 Asbestos-Cement 9 Other (specify below) Welded  
 7 Fiberglass Threaded  
 Blank casing dia: 6 in. to 40 ft., Dia: 6 in. to 63 ft., Dia: ... in. to ... ft.  
 Casing height above land surface: 24 in., weight: 3.58 lbs./ft. Wall thickness or gauge No: 280

TYPE OF SCREEN OR PERFORATION MATERIAL:  
 1 Steel 3 Stainless steel 5 Fiberglass 7 PVC 10 Asbestos-cement  
 2 Brass 4 Galvanized steel 6 Concrete tile 8 RMP (SR) 11 Other (specify)  
 9 ABS 12 None used (open hole)  
 Screen or Perforation Openings Are:  
 1 Continuous slot 3 Mill slot 5 Gauzed wrapped 8 Saw cut 11 None (open hole)  
 2 Louvered shutter 4 Key punched 6 Wire wrapped 9 Drilled holes  
 7 Torch cut 10 Other (specify)  
 Screen-Perforation Dia: 6 in. to 60 ft., Dia: ... in. to ... ft.  
 Screen-Perforated Intervals: From 40 ft. to 60 ft., From ... ft. to ... ft.  
 Gravel Pack Intervals: From 10 ft. to 63 ft., From ... ft. to ... ft.

5 GROUT MATERIAL: 1 Neat cement 2 Cement grout 3 Bentonite 4 Other  
 Grouted Intervals: From 0 ft. to 10 ft., From ... ft. to ... ft.

What is the nearest source of possible contamination:  
 1 Septic tank 4 Cess pool 7 Sewage lagoon 10 Fuel storage 14 Abandoned water well  
 2 Sewer lines 5 Seepage pit 8 Feed yard 11 Fertilizer storage 15 Oil well/Gas well  
 3 Lateral lines 6 Pit privy 9 Livestock pens 12 Insecticide storage 16 Other (specify below)  
 13 Watertight sewer lines  
 Direction from well: north How many feet: 50? Water Well Disinfected? Yes  No  
 Has a chemical/bacteriological sample submitted to Department? Yes  No  If yes, date sample submitted: ... month ... day ... year: Pump Installed? Yes  No   
 Yes: Pump Manufacturer's name: ... Model No.: ... HP: ... Volts: ...  
 Depth of Pump Intake: ... ft. Pumps Capacity rated at: ... gal./min.  
 Type of pump: 1 Submersible 2 Turbine 3 Jet 4 Centrifugal 5 Reciprocating 6 Other

CONTRACTOR'S OR LANDOWNER'S CERTIFICATION: This water well was (1) constructed, (2) reconstructed, or (3) plugged under my jurisdiction and was completed on July month 19 day 1980 year  
 and this record is true to the best of my knowledge and belief. Kansas Water Well Contractor's License No. 285  
 This Water Well Record was completed on August month 2 day 1980 year under the business name of Jones Brothers Water Well Service by (signature) James F. Jones

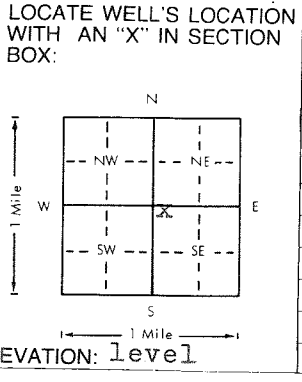

FROM	TO	LITHOLOGIC LOG	FROM	TO	LITHOLOGIC LOG
0	18	Top soil			
18	35	sand and clay			
35	60	sand			
60	67	blue shale			

Depth(s) Groundwater Encountered 1. 35 ft. 2. 60 ft. 3. ... ft. 4. ... ft. (Use a second sheet if needed)  
 INSTRUCTIONS: Use typewriter or ball point pen, please press firmly and PRINT clearly. Please fill in blanks, underline or circle the correct answers. Send top three copies to Kansas Department of Health and Environment, Division of Environment, Water Well Contractors, Topeka, KS 66620. Send one to WATER WELL OWNER and retain one for your records.

OFFICE USE ONLY  
T  
9  
R  
18  
SEC  
11/11/80  
1/4  
SE  
1/4