


WATER WELL RECORD Form WWC-5 KSA 82a-1212

1 LOCATION OF WATER WELL:	Fraction NW ¼ NW ¼ NW ¼	Section Number 35	Township Number T 9 S	Range Number R 18 E/W
----------------------------------	-------------------------	-------------------	-----------------------	--

Distance and direction from nearest town or city street address of well if located within city?
 704 West Mill, Plainville, KS MW 15

2 WATER WELL OWNER: Jack Turnbull
 RR#, St. Address, Box # : P.O. Box 367
 City, State, ZIP Code : Plainville, KS 67663
Board of Agriculture, Division of Water Resources
 Application Number:

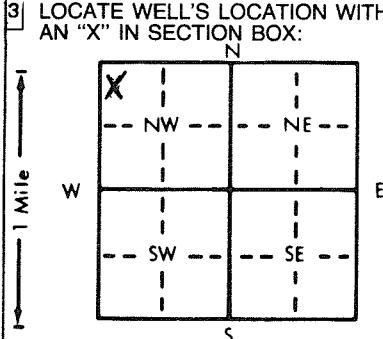

4 DEPTH OF COMPLETED WELL 40 ft. **ELEVATION:**
 Depth(s) Groundwater Encountered 1. 30 ft. 2. ft. 3. ft.
WELL'S STATIC WATER LEVEL 29.50 ft. below land surface measured on mo/day/yr 12-2-91
 Pump test data: Well water was ft. after hours pumping gpm
 Est. Yield gpm: Well water was ft. after hours pumping gpm
 Bore Hole Diameter 7.5/8 in. to 39 ft., and in. to ft.
WELL WATER TO BE USED AS: 5 Public water supply 8 Air conditioning 11 Injection well
 1 Domestic 3 Feedlot 6 Oil field water supply 9 Dewatering 12 Other (Specify below)
 2 Irrigation 4 Industrial 7 Lawn and garden only **10 Monitoring well**
 Was a chemical/bacteriological sample submitted to Department? Yes.....No.....
Water Well Disinfected? Yes No

5 TYPE OF BLANK CASING USED:

1 Steel	3 RMP (SR)	5 Wrought iron	8 Concrete tile	CASING JOINTS: Glued Clamped
2 PVC	4 ABS	6 Asbestos-Cement	9 Other (specify below)	Welded
Blank casing diameter 2 in. to 19 ft., Dia	7 Fiberglass	Threaded <input checked="" type="checkbox"/>

Casing height above land surface 0 in., weight lbs./ft. Wall thickness or gauge No. Schedule 40

TYPE OF SCREEN OR PERFORATION MATERIAL:

1 Steel	3 Stainless steel	5 Fiberglass	7 PVC	10 Asbestos-cement
2 Brass	4 Galvanized steel	6 Concrete tile	8 RMP (SR)	11 Other (specify)
.....	9 ABS	12 None used (open hole)

SCREEN OR PERFORATION OPENINGS ARE:

1 Continuous slot	3 Mill slot	5 Gauzed wrapped	8 Saw cut	11 None (open hole)
2 Louvered shutter	4 Key punched	6 Wire wrapped	9 Drilled holes
.....	7 Torch cut	10 Other (specify)

SCREEN-PERFORATED INTERVALS: From 19 ft. to 39 ft., From ft. to ft.
 From ft. to ft., From ft. to ft.

GRAVEL PACK INTERVALS: From 17 ft. to 39 ft., From ft. to ft.
 From ft. to ft., From ft. to ft.

6 GROUT MATERIAL: 1 Neat cement **2 Cement grout** **3 Bentonite** 4 Other

Grout Intervals: From 0 ft. to (cement) ft., From 1 ft. to 17 (bent) ft., From ft. to ft.

What is the nearest source of possible contamination:

1 Septic tank	4 Lateral lines	7 Pit privy	10 Livestock pens	14 Abandoned water well
2 Sewer lines	5 Cess pool	8 Sewage lagoon	11 Fuel storage	15 Oil well/Gas well
3 Watertight sewer lines	6 Seepage pit	9 Feedyard	12 Fertilizer storage	16 Other (specify below)
.....	13 Insecticide storage

Direction from well? Northwest How many feet? 290

FROM	TO	LITHOLOGIC LOG	FROM	TO	PLUGGING INTERVALS
0	12	Clay, lt. brown, silty			
12	13	Chalk, white			KDHE Tag #00480095
13	17	Clay, lt. brown			Flush mount cover
17	19	Chalk, white			
19	27	Sand, white, fine			
27	29	Sand, white, coarse			
29	29.5	Clay, lt. green, sandy			
29.5	40	Sand, yellow, fine to med.			

7 CONTRACTOR'S OR LANDOWNER'S CERTIFICATION: This water well was **1** constructed, (2) reconstructed, or (3) plugged under my jurisdiction and was completed on (mo/day/year) 11-12-91 and this record is true to the best of my knowledge and belief. Kansas Water Well Contractor's License No. 527. This Water Well Record was completed on (mo/day/yr) 11-26-91 under the business name of GeoCore Services, Inc. by (signature) Dale Roll

INSTRUCTIONS: Use typewriter or ball point pen. PLEASE PRESS FIRMLY and PRINT clearly. Please fill in blanks, underline or circle the correct answers. Send top three copies to Kansas Department of Health and Environment, Bureau of Water, Topeka, Kansas 66620-0001. Telephone: 913-296-5545. Send one to WATER WELL OWNER and retain one for your records.