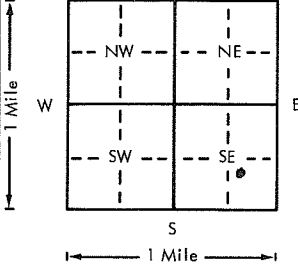
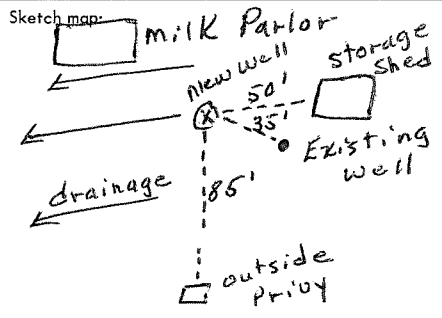


USE TYPEWRITER OR BALL POINT PEN-PRESS FIRMLY, PRINT CLEARLY.

WATER WELL RECORD
KSA 82a-1201-1215

Kansas Department of Health and Environment-Division of Environment (Water well Contractors) Topeka, Kansas 66620

1. Location of well:	County Rooks	Fraction SW NW 1/4 SE 1/4 SE 1/4	Section number 26	Township number T 9 S	Range number R 19 EW
2. Distance and direction from nearest town or city: 5 1/4 miles West, 1/2 Mile North Street address of well location if in city: Plainville, Ks.			3. Owner of well: Austin Thomas R.R. or street: Zurich, Kansas City, state, zip code:		
4. Locate with "X" in section below: 		Sketch map: 		6. Bore hole dia. <u>1 1/2</u> in. Completion date <u>1-2-79</u> Well depth <u>114</u> ft.	
5. Type and color of material		From	To	7. Cable tool <input checked="" type="checkbox"/> Rotary <input type="checkbox"/> Driven <input type="checkbox"/> Dug <input type="checkbox"/> Hollow rod <input type="checkbox"/> Jetted <input type="checkbox"/> Bored <input type="checkbox"/> Reverse rotary	
Sandy soil		0	4	8. Use: <input type="checkbox"/> Domestic <input type="checkbox"/> Public supply <input type="checkbox"/> Industry <input type="checkbox"/> Irrigation <input type="checkbox"/> Air conditioning <input checked="" type="checkbox"/> Stock <input type="checkbox"/> Lawn <input type="checkbox"/> Oil field water <input type="checkbox"/> Other	
Small to med river gravel with sandy clay stringers		4	24	9. Casing: Material <u>pits</u> Height: Above or below Threaded <input type="checkbox"/> Welded <input checked="" type="checkbox"/> Surface <u>24</u> in. RMP <input checked="" type="checkbox"/> PVC <input type="checkbox"/> Weight <u>3.58</u> lbs./ft. Dia. <u>6</u> in. to <u>66</u> ft. depth Wall Thickness: inches or Dia. <u>6</u> in. to <u>66</u> ft. depth gage No. <u>.0325</u>	
Sandy clay stringers		24	28	10. Screen: Manufacturer's name <u>MPI</u> Type <u>PVC</u> Dia. <u>6</u> " Slot/gauze <u>1/16</u> Length <u>30</u> ' Set between <u>66</u> ft. and <u>96</u> ft. Gravel pack? <input checked="" type="checkbox"/> yes Size range of material <u>1/8-3/16</u>	
Bigger % of sand & gravel in clay		28	35	11. Static water level: _____ mo./day/yr. <u>44'4"</u> ft. below land surface Date <u>1-2-79</u>	
Fine sand to med sand		35	40	12. Pumping level below land surfaces: <u>44'4"</u> ft. after <u>1</u> hrs. pumping <u>20</u> g.p.m. <u>44'4"</u> ft. after <u>1</u> hrs. pumping <u>20</u> g.p.m. Estimated maximum yield <u>1,000</u> g.p.m.	
Fine sand to med gravel with clay stringers		40	55	13. Water sample submitted: 1-2-79 mo./day/yr. <input type="checkbox"/> Yes <input checked="" type="checkbox"/> No Date _____	
Fine sand to med sand with open sand stone		55	80	14. Well head completion: <input type="checkbox"/> Pitless adapter <u>36</u> " Inches above grade	
Med river sand clean with sand rock		80	93	15. Well grouted? <input checked="" type="checkbox"/> yes With: <input type="checkbox"/> Neat cement <input type="checkbox"/> Bentonite <input checked="" type="checkbox"/> Concrete Depth: From <u>0</u> ft. to <u>10</u> ft.	
Yellow clay		93	96	16. Nearest source of possible contamination: <u>85'</u> <u>south</u> <u>outdoor toilet</u> ft. _____ Direction _____ Type _____ Well disinfected upon completion? <input type="checkbox"/> Yes <input checked="" type="checkbox"/> No	
Tan clay with some sand embedded		96	113	17. Pump: <input checked="" type="checkbox"/> Not installed Manufacturer's name _____ Model number _____ HP _____ Volts _____ Length of drop pipe _____ ft. capacity _____ g.p.m. Type: <input type="checkbox"/> Submersible <input type="checkbox"/> Turbine <input type="checkbox"/> Jet <input type="checkbox"/> Reciprocating <input type="checkbox"/> Centrifugal <input type="checkbox"/> Other	
Blue shale		113	114	20. Water well contractor's certification: This well was drilled under my jurisdiction and this report is true to the best of my knowledge and belief. JRW Water Service 327 Business name _____ License No. _____ Address <u>Rt1, Box 27, Stockton, KS</u> Signed <u>Walter Jackson</u> Date <u>2-7-79</u> Authorized representative	
18. Elevation:		(Use a second sheet if needed)		19. Remarks: Special permission obtained from Dwight to install round well curb extending mim. of 2' from well casing @ all points. Very attractive completion.	
Topography: <input type="checkbox"/> Hill <input type="checkbox"/> Slope <input checked="" type="checkbox"/> Upland <input type="checkbox"/> Valley					

T 9
 R 19
 W 26
 Sec 26
 NW
 SE
 SW
 NE