USE TYPEWRITER OR BALL POINT PEN-PRESS FIRMLY, PRINT CLEARLY.

WATER WELL RECORD
KSA 82a-1201-1215

Kansas Department of Health and Environment-Division of Environment
(Water well Contractors)
Topeka, Kansas 66620

1. Location of well:	County	Fraction	Section number	Township number	Range number
	Rooks	Northwest SW 1/4 NW1/4 NW1/4	34	T 9 South S	R 19 West E/W

2. Distance and direction from nearest town or city: 1/2 Zurich, Kansas
Street address of well location if in city: South of Hwy 18

3. Owner of well: St. Ann Church
R.R. or street:
City, state, zip code: Zurich, Kansas

4. Locate with "X" in section below:

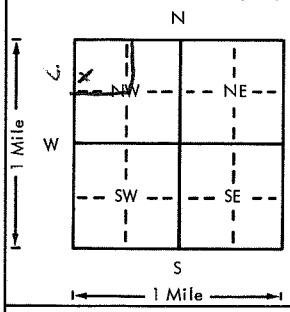

Sketch map:

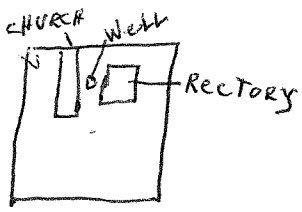

6. Bore hole dia. 9 in. Completion date 2-1-76
Well depth 85 ft.

7. __ Cable tool X Rotary __ Driven __ Dug
__ Hollow rod __ Jetted __ Bored __ Reverse rotary

8. Use: X Domestic __ Public supply __ Industry
__ Irrigation __ Air conditioning __ Stock
__ Lawn __ Oil field water __ Other

9. Casing: Material PVC Height: Above or below
Threaded ___ Welded ___ Surface 12 in.
RMP ___ PVC X Weight ___ lbs./ft.
Dia. 5 in. to 85 ft. depth Wall Thickness: inches or
Dia. ___ in. to ___ ft. depth gage No. 200

10. Screen: Manufacturer's name PVC Jesse Lowell
Type PVC Dia. 5"
Slot/gauze 1/8" Length 10'
Set between 75 ft. and 85 ft.
___ ft. and ___ ft.
Gravel pack? Yes Size range of material 1/8 x 1/4

11. Static water level: mo./day/yr.
65 ft. below land surface Date 2-1-76

12. Pumping level below land surfaces:
70 ft. after 1 hrs. pumping 20 g.p.m.
___ ft. after ___ hrs. pumping ___ g.p.m.
Estimated maximum yield 40 g.p.m.

13. Water sample submitted: mo./day/yr.
__ Yes X No Date ___

14. Well head completion:
__ Pitless adapter 12 Inches above grade

15. Well grouted? X
With: X Neat cement ___ Bentonite ___ Concrete
Depth: From 6 ft. to 40 ft.

16. Nearest source of possible contamination:
ft. 75 Direction South Type Septic Tank
Well disinfected upon completion? X Yes ___ No

17. Pump: X Not installed
Manufacturer's name ___
Model number ___ HP ___ Volts ___
Length of drop pipe ___ ft. capacity ___ g.p.m.
Type:
__ Submersible __ Turbine
__ Jet __ Reciprocating
__ Centrifugal __ Other

5. Type and color of material

Type and color of material	From	To
Black Dirt	0	12
Clay	12	32
Fine Sand	32	60
Coarser Sand	60	82
Blue Shale	82	85

(Use a second sheet if needed)

18. Elevation:

Topography:
__ Hill
__ Slope
X Upland
__ Valley

19. Remarks:

20. Water well contractor's certification:
This well was drilled under my jurisdiction and this report is true to the best of my knowledge and belief. 269 A
P & D Well Drilling
Business name License No.
Address Box 42 Palco Ks
Signed Paul Schulz Date 3-18-76
Authorized representative

T 9 S R 19 W Sec 34 1/4 SW 1/4 NW 1/4

Forward the white, blue and pink copies to the Department of Health and Environment

Form WWC-5

MI-1023