


1 LOCATION OF WATER WELL: Fraction NE NE 1/4 NE 1/4 Section Number 32 Township Number T 9 S Range Number R 20 EW
 County: Rooks

Distance and direction from nearest town or city street address of well if located within city?
285 X Road, Palco, KS.

2 WATER WELL OWNER: Delbert Ostrom
 RR#, St. Address, Box #: 285 X Road Board of Agriculture, Division of Water Resources
 City, State, ZIP Code: Palco, Ks. Application Number:

3 LOCATE WELL'S LOCATION WITH AN "X" IN SECTION BOX:

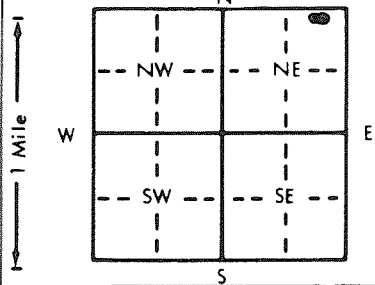

4 DEPTH OF COMPLETED WELL: 40' ft. ELEVATION:
 Depth(s) Groundwater Encountered 1. 33' ft. 2. ft. 3. ft.
 WELL'S STATIC WATER LEVEL 32.82 ft. below land surface measured on mo/day/yr 12-4-96
 Pump test data: Well water was ft. after hours pumping gpm
 Est. Yield gpm: Well water was ft. after hours pumping gpm
 Bore Hole Diameter: 3/8 in. to 40' ft. and in. to ft.
 WELL WATER TO BE USED AS:
 1 Domestic 3 Feedlot 5 Public water supply 8 Air conditioning 11 Injection well
 2 Irrigation 4 Industrial 6 Oil field water supply 9 Dewatering 12 Other (Specify below)
 7 Lawn and garden only 10 Monitoring well
 Was a chemical/bacteriological sample submitted to Department? Yes No If yes, mo/day/yr sample was submitted
 Water Well Disinfected? Yes No

5 TYPE OF BLANK CASING USED:
 1 Steel 3 RMP (SR) 5 Wrought iron 8 Concrete tile CASING JOINTS: Glued Clamped
 2 PVC 4 ABS 6 Asbestos-Cement 9 Other (specify below) Welded
 7 Fiberglass Threaded
 Blank casing diameter 2.375 in. to 25' ft. Dia. in. to SDR 13 ft.
 Casing height above land surface Flush Mt. in., weight lbs./ft. Wall thickness or gauge No. Sch. 40

TYPE OF SCREEN OR PERFORATION MATERIAL:
 1 Steel 3 Stainless steel 5 Fiberglass 8 RMP (SR) 10 Asbestos-cement
 2 Brass 4 Galvanized steel 6 Concrete tile 9 ABS 11 Other (specify)
 12 None used (open hole)

SCREEN OR PERFORATION OPENINGS ARE:
 1 Continuous slot 3 Mill slot 5 Gauzed wrapped 8 Saw cut 11 None (open hole)
 2 Louvered shutter 4 Key punched 6 Wire wrapped 9 Drilled holes
 7 Torch cut 10 Other (specify)

SCREEN-PERFORATED INTERVALS: From 40' ft. to 25' ft. From ft. to ft.
 From ft. to ft. From ft. to ft.
 GRAVEL PACK INTERVALS: From 40' ft. to 23' ft. From ft. to ft.
 From ft. to ft. From ft. to ft.

6 GROUT MATERIAL:
 1 Neat cement 2 Cement grout 3 Bentonite 4 Other
 Grout Intervals: From 23' ft. to 4' ft. From 4' ft. to 0' ft. From ft. to ft.

What is the nearest source of possible contamination:
 1 Septic tank 4 Lateral lines 7 Pit privy 10 Livestock pens 14 Abandoned water well
 2 Sewer lines 5 Cess pool 8 Sewage lagoon 11 Fuel storage Fueler 15 Oil well/Gas well
 3 Watertight sewer lines 6 Seepage pit 9 Feedyard 12 Fertilizer storage 16 Other (specify below)
 13 Insecticide storage
 Direction from well? West How many feet? 10'

FROM	TO	LITHOLOGIC LOG	FROM	TO	PLUGGING INTERVALS
0	.50	Gravel, road pack, hard, dry.			
.50	5	Dk brn clay, dry to moist, firm, low plasticity.			
5	8.75	Fine-coarse sand, dry, no odor, well graded, subrounded.			
8.75	14	Tan brn silty clay, dry, no odor, firm, trace of caliche.			
14	18.50	Pale green silty clay w/ caliche stringers, mottled, dry, firm.			
18.50	25	Pale green clayey sand to sand, moist, firm, mod. odor.			
25	35	Lt pink to red clayey sand, moist, mod. odor, fine-coarse sand w/ faint gray banding.			
35	40	Chalky white sand, wet, strong odor.			

F.H. OK'd by D. Taylor

7 CONTRACTOR'S OR LANDOWNER'S CERTIFICATION: This water well was (1) constructed, (2) reconstructed, or (3) plugged under my jurisdiction and was completed on (mo/day/year) 12-2-96 and this record is true to the best of my knowledge and belief. Kansas Water Well Contractor's License No. 539 This Water Well Record was completed on (mo/day/yr) 12-16-96 under the business name of JB Environmental Drilling by (signature) James Becker

OFFICE USE ONLY
T
R
EW
SEC.
1/4
1/4
1/4