


1 LOCATION OF WATER WELL: County: Rooks	Fraction NW ¼ NE ¼ NE ¼	Section Number 32	Township Number T 9 S	Range Number R 20 E/W
---	-----------------------------------	-----------------------------	---------------------------------	---------------------------------

Distance and direction from nearest town or city street address of well if located within city?
285 X Road, Palco

2 WATER WELL OWNER: **OWS, Inc.**
 RR#, St. Address, Box # : **285 X Road**
 City, State, ZIP Code : **Palco, Kansas 67663**
 Board of Agriculture, Division of Water Resources
 Application Number:

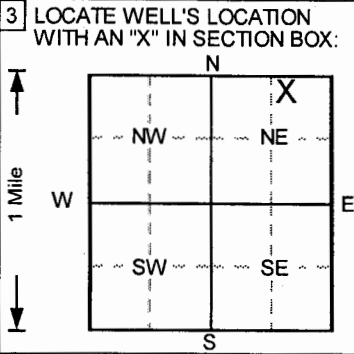

4 DEPTH OF COMPLETED WELL **50** ft. ELEVATION:

Depth(s) Groundwater Encountered 1. ft. 2. ft. 3. ft.

WELL'S STATIC WATER LEVEL ft. below land surface measured on mo/day/yr

Pump test data: Well water was **NA** ft. after hours pumping gpm

Est. Yield **NA** gpm: Well water was ft. after hours pumping gpm

Bore Hole Diameter **8** in. to **50** ft., and in. to ft.

WELL WATER TO BE USED AS: 5 Public water supply 8 Air conditioning 11 Injection well
 1 Domestic 3 Feedlot 6 Oil field water supply 9 Dewatering **12 Other (Specify below)**
 2 Irrigation 4 Industrial 7 Lawn and garden only 10 Monitoring well **Air sparge**

Was a chemical/bacteriological sample submitted to Department? Yes.....No ..; If yes, mo/day/yr sample was submitted

Water Well Disinfected? Yes No

5 TYPE OF BLANK CASING USED:

1 Steel	3 RMP (SR)	5 Wrought iron	8 Concrete tile	CASING JOINTS: Glued Clamped
2 PVC	4 ABS	6 Asbestos-Cement	9 Other (specify below)	Welded
		7 Fiberglass		Threaded. <input checked="" type="checkbox"/>

Blank casing diameter **2** in. to **48** ft., Dia in. to ft., Dia in. to ft.

Casing height above land surface **0** in., weight lbs./ft. Wall thickness or gauge No. **Sch. 40**

TYPE OF SCREEN OR PERFORATION MATERIAL

1 Steel	3 Stainless steel	5 Fiberglass	7 PVC	10 Asbestos-cement
2 Brass	4 Galvanized steel	6 Concrete tile	8 RMP (SR)	11 Other (specify)
			9 ABS	12 None used (open hole)

SCREEN OR PERFORATION OPENINGS ARE:

1 Continuous slot	3 Mill slot	5 Gauzed wrapped	8 Saw cut	11 None (open hole)
2 Louvered shutter	4 Key punched	6 Wire wrapped	9 Drilled holes	
		7 Torch cut	10 Other (specify)	

SCREEN-PERFORATED INTERVALS: From **48** ft. to **50** ft., From ft. to ft.

GRAVEL PACK INTERVALS: From **45** ft. to **50** ft., From ft. to ft.

6 GROUT MATERIAL: 1 Neat cement 2 Cement grout **3 Bentonite** 4 Other

Grout Intervals: From **0** ft. to **2** ft., From **2** ft. to **45** ft., From ft. to ft.

What is the nearest source of possible contamination:

1 Septic tank	4 Lateral lines	7 Pit privy	10 Livestock pens	14 Abandoned water well
2 Sewer lines	5 Cess pool	8 Sewage lagoon	11 Fuel storage	15 Oil well/Gas well
3 Watertight sewer lines	6 Seepage pit	9 Feedyard	12 Fertilizer storage	16 Other (specify below)
			13 Insecticide storage	

Direction from well? How many feet?

FROM	TO	LITHOLOGIC LOG	FROM	TO	PLUGGING INTERVALS
0	1	Clay and Gravel,			
1	3	Clay, moist, plastic, no odor,			
3	9	Clay, v. silty, sl. moist, Lt. Brown			
9	13	Clay, sl. silty, moist, v. sl. odor, Brown w/white			
13	14	Clay, chalky, "caliche", sl. odor, V. Lt. Gray t			
14	19	Clay, silty, moist, mod. odor, Brown w/white c			
19	22	Sand (vf-f), silty, moist, no odor, Brown			
22	26	Sand (vf-m), silty, occ. white calc. material, Br			
26	33	Sand (vf-m), occ. "caliche", v. sl. moist, Lt. Re			
33	35.5	Sand (vf-c) w/tr. f gravel, moist, Lt. Brown			
35.5	44	Sand (vf-c) w/f-m gravel, Lt. Brown			
44	50	Sand (f-c) w/tr. f gravel, subrounded, Brown			
					AS3, Flushmount
					Project Name: GF - OWS, Inc.
					GeoCore # 1273, KDHE # U6 082 00709

7 CONTRACTOR'S OR LANDOWNER'S CERTIFICATION: This water well was **(1)** constructed, (2) reconstructed, or (3) plugged under my jurisdiction and was completed on (mo/day/year) **4/25/2006** and this record is true to the best of my knowledge and belief.

Kansas Water Well Contractor's License No. **527** This Water Well Record was completed on (mo/day/yr) **6/7/2006** under the business name of **GeoCore, Inc.** by (signature) *Bob Hall*

OFFICE USE ONLY
T
R
EW
SEC.
1/4
1/4
1/4