


MW - 7

| | | | | | |
|---|-------------------------|-----------------------------|----------------|-----------------|--|
| 1 | LOCATION OF WATER WELL: | Fraction | Section Number | Township Number | Range Number |
| | County: <u>Rooks</u> | <u>NE 1/4 NW 1/4 NE 1/4</u> | <u>32</u> | <u>9S</u> | <u>20</u> EW |

Distance and direction from nearest town or city street address of well if located within city?
285 X Road Palco, KS 67657

2 WATER WELL OWNER: OWS, Inc.
 RR #, St. Address, Box #: P.O. Box 368 Board of Agriculture, Division of Water Resources
 City, State, ZIP Code: Plainville, KS 67663 Application Number:

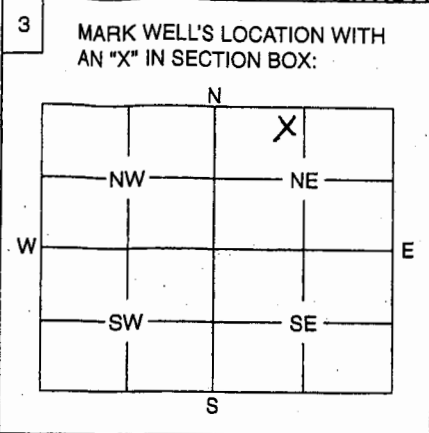

4 DEPTH OF WELL 40 ft.
 WELL'S STATIC WATER LEVEL 36.4 ft.
 WELL WAS USED AS:

| | | |
|--------------|----------------------------|--|
| 1 Domestic | 5 Public Water Supply | 9 Dewatering |
| 2 Irrigation | 6 Oil Field Water Supply | <input checked="" type="checkbox"/> 10 Monitoring Well |
| 3 Feedlot | 7 Domestic (Lawn & Garden) | 11 Injection Well |
| 4 Industrial | 8 Air Conditioning | 12 Other |

Was a chemical / bacteriological sample submitted to Department? Yes No
 If yes, mo/day/yr sample was submitted

Water Well Disinfected: Yes No

5 TYPE OF BLANK CASING USED:

| | | | | |
|---|------------|-------------------|-----------------|-------------------------|
| 1 Steel | 3 RMP (SR) | 5 Wrought | 7 Fiberglass | 9 Other (Specify below) |
| <input checked="" type="checkbox"/> 2 PVC | 4 ABS | 6 Asbestos-Cement | 8 Concrete Tile | |

Blank casing diameter 2 in. Was casing pulled? Yes No If yes, how much 3'
 Casing height above or below land surface in.

6 GROUT PLUG MATERIAL: 1 Neat cement 2 Cement grout Bentonite 4 Other

Grout Plug Intervals: From 3 ft. to 40 ft., From ft. to ft., From to ft.

What is the nearest source of possible contamination:

| | | | |
|--------------------------|-------------------|-------------------------|--|
| 1 Septic tank | 6 Seepage pit | 11 Fuel storage | <input checked="" type="checkbox"/> 16 Other (specify below) |
| 2 Sewer lines | 7 Pit privy | 12 Fertilizer storage | <u>Hydraulic oil</u> |
| 3 Watertight sewer lines | 8 Sewage lagoon | 13 Insecticide storage | |
| 4 Lateral lines | 9 Feedyard | 14 Abandoned water well | |
| 5 Cess pool | 10 Livestock pens | 15 Oil well/Gas well | |

Direction from well? N How many feet? 30

| FROM | TO | PLUGGING MATERIALS |
|-----------|------------|------------------------|
| <u>0'</u> | <u>3'</u> | <u>Native material</u> |
| <u>3'</u> | <u>40'</u> | <u>Bentonite chips</u> |
| | | |
| | | |
| | | |
| | | |

RECEIVED
 NOV 14 2008
BUREAU OF WATER

7 CONTRACTOR'S OR LANDOWNER'S CERTIFICATION: This water well was plugged under my jurisdiction and was completed on (mo/day/year) 11-11-08 and this record is true to the best of my knowledge and belief. Kansas Water Well Contractor's License No. This Water Well Record was completed on (mo/day/year) 11-13-08 under the business name of Green Field Contractors by (signature) Jean T. ...

INSTRUCTIONS: Use typewriter or ball point pen. Please press firmly and print clearly. Please fill in blanks, underline or circle the correct answers. Send top three copies to Kansas Department of Health and Environment, Bureau of Water, Geology Section, 1000 SW Jackson St., Ste. 420, Topeka, Kansas 66612-1367. Telephone: 785/296-5522. Send one to Water Well Owner and retain one for your records.