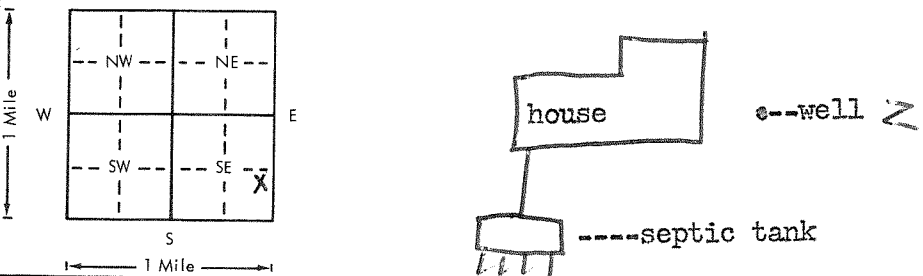


USE TYPEWRITER OR BALL POINT PEN-PRESS FIRMLY, PRINT CLEARLY.

WATER WELL RECORD
KSA 82a-1201-1215

Kansas Department of Health and Environment-Division of Environment
(Water well Contractors)
Topeka, Kansas 66620

1. Location of well: County: Rooks		Fraction: SE NE 1/4 SE 1/4 SE 1/4		Section number: 29	Township number: 9 S R	Range number: 20 E/W
2. Distance and direction from nearest town or city: Street address of well location if in city: 1 south 1/2 west PALCO			3. Owner of well: Ron Knipp R.R. or street: Palco, Ks. City, state, zip code:			
4. Locate with "X" in section below: N W E S 1 Mile Sketch map: 			6. Bore hole dia. 9 in. Completion date: 6-28-79 Well depth 60 ft.			
5. Type and color of material			7. <input checked="" type="checkbox"/> Cable tool Rotary <input type="checkbox"/> Driven <input type="checkbox"/> Dug <input type="checkbox"/> Hollow rod <input type="checkbox"/> Jetted <input type="checkbox"/> Bored <input type="checkbox"/> Reverse rotary			
			8. Use: <input checked="" type="checkbox"/> Domestic <input type="checkbox"/> Public supply <input type="checkbox"/> Industry <input type="checkbox"/> Irrigation <input type="checkbox"/> Air conditioning <input type="checkbox"/> Stock <input type="checkbox"/> Lawn <input type="checkbox"/> Oil field water <input type="checkbox"/> Other			
			9. Casing: Material pvc Height: Above or below Threaded <input type="checkbox"/> Welded <input checked="" type="checkbox"/> Surface 18 in. RMP <input type="checkbox"/> PVC <input checked="" type="checkbox"/> Weight 200 lbs./ft. Dia. 5 in. to 60 ft. depth Wall Thickness: inches or Dia. <input type="checkbox"/> in. to <input type="checkbox"/> ft. depth gage No. .26			
			10. Screen: Manufacturer's name Jet stream Type pvc Dia. 5 Slot/size 031 Length 10 Set between 50 ft. and 60 ft. <input type="checkbox"/> ft. and <input type="checkbox"/> ft. Gravel pack? <input checked="" type="checkbox"/> Size range of material 1/2-1/4			
topsoil			From	To	11. Static water level: 45 ft. below land surface Date 6-28-79 mo./day/yr.	
clay			0	3	12. Pumping level below land surfaces: 45 ft. after 1 hrs. pumping 10 g.p.m. ft. after _____ hrs. pumping _____ g.p.m. Estimated maximum yield _____ g.p.m.	
sand and sandstone			3	45	13. Water sample submitted: _____ mo./day/yr. <input type="checkbox"/> Yes <input checked="" type="checkbox"/> No Date _____	
brown shale			45	57	14. Well head completion: _____ Pitless adapter 18 Inches above grade	
			57	60	15. Well grouted? <input checked="" type="checkbox"/> With: <input checked="" type="checkbox"/> Neat cement <input type="checkbox"/> Bentonite <input type="checkbox"/> Concrete Depth: From 0 ft. to 10 ft.	
					16. Nearest source of possible contamination: ft. 150 Direction SE Type sewer Well disinfected upon completion? <input checked="" type="checkbox"/> Yes <input type="checkbox"/> No	
					17. Pump: <input checked="" type="checkbox"/> Not installed Manufacturer's name _____ Model number _____ HP _____ Volts _____ Length of drop pipe _____ ft. capacity _____ g.p.m. Type: <input type="checkbox"/> Submersible <input type="checkbox"/> Turbine <input type="checkbox"/> Jet <input type="checkbox"/> Reciprocating <input type="checkbox"/> Centrifugal <input type="checkbox"/> Other	
(Use a second sheet if needed)					20. Water well contractor's certification: This well was drilled under my jurisdiction and this report is true to the best of my knowledge and belief. Karst Water Well 199 Business name E. Hieay 40 Hays, Ks. License No. _____ Address The Karst Signed The Karst Authorized representative Date 6-28-79	
18. Elevation:		19. Remarks:				
Topography: <input type="checkbox"/> Hill <input checked="" type="checkbox"/> Slope <input type="checkbox"/> Upland <input type="checkbox"/> Valley						

T-9
 R-20
 W-29
 Sec-29
 NE/SE
 1/4 1/4

Forward the white, blue and pink copies to the Department of Health and Environment