USE TYPEWRITER OR BALL POINT PEN-PRESS FIRMLY, PRINT CLEARLY.

WATER WELL RECORD
KSA 82a-1201-1215

Kansas Department of Health and Environment-Division of Environment
(Water well Contractors)
Topeka, Kansas 66620

1. Location of well:	County: Rooks	Fraction: NW 1/4 NW 1/4 NW 1/4	Section number: 33	Township number: T 9 S	Range number: R 20 W E/W

2. Distance and direction from nearest town or city: 1½ south Paco
Street address of well location if in city:

3. Owner of well: Eppie Burgerman
R.R. or street:
City, state, zip code: Paco, Kansas

4. Locate with "X" in section below:

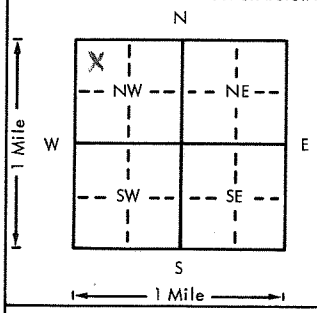

Sketch map:

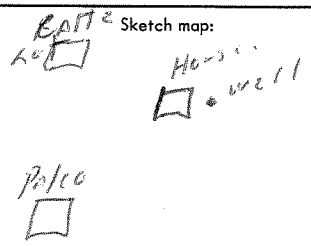

6. Bore hole dia. 9 in. Completion date 5-1-76
Well depth 60 ft.

7. __ Cable tool X Rotary __ Driven __ Dug
__ Hollow rod __ Jetted __ Bored __ Reverse rotary

8. Use: X Domestic __ Public supply __ Industry
__ Irrigation __ Air conditioning __ Stock
__ Lawn __ Oil field water __ Other

9. Casing: Material PVC Height: Above or below
Threaded ___ Welded ___ Surface 15" in.
RMP ___ PVC X Weight ___ lbs./ft.
Dia. 5 in. to 60 ft. depth Wall Thickness: inches or
Dia. ___ in. to ___ ft. depth gage No. 200

5. Type and color of material	From	To
Black Dirt	0	12
Clay	12	40
Clay + Sand	40	46
Fine Sand	46	55
Water Gravel	55	60
(Use a second sheet if needed)		

10. Screen: Manufacturer's name Paco Special
Type PVC Dia. 5"
Slot/gauze 1/4" Length 10'
Set between 50 ft. and 60 ft.
___ ft. and ___ ft.
Gravel pack? Yes Size range of material 1/8 x 1/4

11. Static water level: mo./day/yr.
46 ft. below land surface Date 5-1-76

12. Pumping level below land surfaces:
55 ft. after 2 hrs. pumping 20 g.p.m.
___ ft. after ___ hrs. pumping ___ g.p.m.
Estimated maximum yield 20 g.p.m.

13. Water sample submitted: mo./day/yr.
__ Yes X No Date ___

14. Well head completion:
X Pitless adapter 18 Inches above grade

15. Well grouted? X
With: ___ Neat cement X Bentonite ___ Concrete
Depth: From 20 ft. to 6 ft.

16. Nearest source of possible contamination:
ft. 10 Direction North Type Cattle
Well disinfected upon completion? X Yes ___ No

17. Pump: X Not installed
Manufacturer's name ___
Model number ___ HP ___ Volts ___
Length of drop pipe ___ ft. capacity ___ g.p.m.
Type:
__ Submersible __ Turbine
__ Jet __ Reciprocating
__ Centrifugal __ Other

18. Elevation: ~2275 Topo Map
Topography:
X Hill
__ Slope
__ Upland
__ Valley

19. Remarks:

20. Water well contractor's certification:
This well was drilled under my jurisdiction and this report is true to the best of my knowledge and belief.
P & J Well Drilling
Business name License No. 169A
Address Box 42
Signed Paul Schmidt Date 5-1-76
Authorized representative

T 9 R 20 E (W) Sec 33 1/4 NW 1/4 NW 1/4 NW 1/4

Forward the white, blue and pink copies to the Department of Health and Environment

Form WWC-5

MI-1023