

CORRECTION(S) TO WATER WELL RECORD (WWC-5)

(to rectify lacking or incorrect information)

County: Graham

Location listed as:

Section-Township-Range: A-14-21W

Fraction ($\frac{1}{4}$ $\frac{1}{4}$ $\frac{1}{4}$): SE

Location changed to:

14-95-21W

NW NW SE

Other changes: Initial statements: _____

Changed to: _____

Comments: _____

verification method: Written description, position on plat map, and
Bogue 1:24,000 topo. map.


initials: DRL date: 4/4/2005

submitted by: Kansas Geological Survey, Data Resources Library, 1930 Constant Ave., Lawrence, KS 66047-3726
to: Kansas Dept of Health & Environment, Bureau of Water, 1000 SW Jackson, Suite 420, Topeka, KS 66612-1367.

1 LOCATION OF WATER WELL:	Fraction	Section	Number	Township	Number	Range	Number
County: Graham	$\frac{1}{4}$ $\frac{1}{4}$ SE $\frac{1}{4}$	4		14		21W	(EW)

Distance and direction from nearest town or city street address of well if located within city?
7 Miles S of Bogue; 3 1/2 Miles E; 1/2 Mile North

2 WATER WELL OWNER: **National Cooperative REfinery**
 RR #, St. Address, Box #: **P.O. Box 1404** Board of Agriculture, Division of Water Resources
 City, State, ZIP Code: **McPherson, Ks 67460** Application Number:

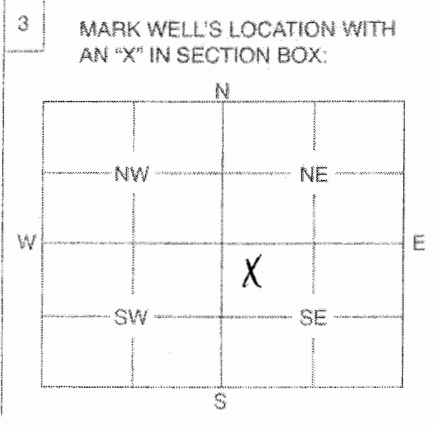

4 DEPTH OF WELL**20**..... ft.
 WELL'S STATIC WATER LEVEL **dry**..... ft.
 WELL WAS USED AS:

1 Domestic	5 Public Water Supply	9 Dewatering
2 Irrigation	6 Oil Field Water Supply	10 Monitoring Well
3 Feedlot	7 Domestic (Lawn & Garden)	11 Injection Well
4 Industrial	8 Air Conditioning	12 Other

Was a chemical / bacteriological sample submitted to Department? Yes No **X**.....
 If yes, mo/day/yr sample was submitted

Water Well Disinfected: Yes No **X**.....

5 TYPE OF BLANK CASING USED:

1 Steel	3 RMP (SR)	5 Wrought	7 Fiberglass	9 Other (Specify below)
2 PVC	4 ABS	6 Asbestos-Cement	8 Concrete Tile	

Blank casing diameter **2**..... in. Was casing pulled? Yes **X** No If yes, how much **20**.....
 Casing height above or below land surface **0**..... in.

6 GROUT PLUG MATERIAL: 1 Neat cement 2 Cement grout **3** Bentonite **4** Other **GS** Surface silts and clays.....
 Grout Plug Intervals: From **20**..... ft. to **3**..... ft. From **3**..... ft. to **GS**..... ft., From to ft.

What is the nearest source of possible contamination:

1 Septic tank	6 Seepage pit	11 Fuel storage	16 Other (specify below)
2 Sewer lines	7 Pit privy	12 Fertilizer storage	
3 Watertight sewer lines	8 Sewage lagoon	13 insecticide storage	
4 Lateral lines	9 Feedyard	14 Abandoned water well	
5 Cess pool	10 Livestock pens	15 Oil well/Gas well	

Direction from well? How many feet?

FROM	TO	PLUGGING MATERIALS
0	3	Surface silt/clay
20	3	Bentonite

7 CONTRACTOR'S OF LANDOWNER'S CERTIFICATION: This water well was plugged under my jurisdiction and was completed on (mo/day/year) **03/05/05** and this record is true to the best of my knowledge and belief. Kansas Water Well Contractor's License No. **585** This Water Well Record was completed on (mo/day/year) **03/21/05** under the business name of **Associated Environmental, Inc.** by (signature) **Darin Duncan**

INSTRUCTIONS: Use typewriter or ball point pen. Please press firmly and print clearly. Please fill in blanks, underline or circle the correct answers. Send top three copies to Kansas Department of Health and Environment, Bureau of Water, Geology Section, 1000 SW Jackson St., Ste. 420, Topeka, Kansas 66612-1367. Telephone: 785/296-5522. Send one to Water Well Owner and retain one for your records.