


1 LOCATION OF WATER WELL: County: Franklin Fraction: NE 1/4 SW 1/4 NW 1/4 Section Number: 18 Township Number: T 9 S Range Number: R 23 EW

Distance and direction from nearest town or city street address of well if located within city? 3/4 mile South & 1/2 mile East of Hell City Kan

2 WATER WELL OWNER: Willie Brandyberry RR#, St. Address, Box #: Hell City Kansas 67642 Board of Agriculture, Division of Water Resources Application Number:

3 LOCATE WELL'S LOCATION WITH AN "X" IN SECTION BOX:

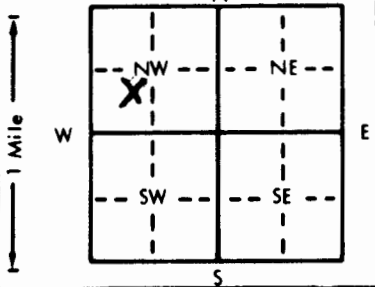

4 DEPTH OF COMPLETED WELL: 60 ft. ELEVATION: Depth(s) Groundwater Encountered 1. 32 ft. 2. ft. 3. ft. WELL'S STATIC WATER LEVEL: 32 ft. below land surface measured on mo/day/yr 5-15-94 Pump test data: Well water was ft. after hours pumping gpm Est. Yield 40 gpm: Well water was ft. after hours pumping gpm Bore Hole Diameter: 10 in. to 60 ft. and in. to ft. WELL WATER TO BE USED AS: 5 Public water supply 8 Air conditioning 11 Injection well 1 Domestic 3 Feedlot 6 Oil field water supply 9 Dewatering 12 Other (Specify below) 2 Irrigation 4 Industrial 7 Lawn and garden only 10 Monitoring well Was a chemical/bacteriological sample submitted to Department? Yes No If yes, mo/day/yr sample was submitted Water Well Disinfected? Yes No

5 TYPE OF BLANK CASING USED: 1 Steel 3 RMP (SR) 5 Wrought iron 8 Concrete tile CASING JOINTS: Glued Clamped 2 PVC 4 ABS 6 Asbestos-Cement 9 Other (specify below) Welded 7 Fiberglass Threaded

Blank casing diameter: 5 in. to 40 ft. Dia. in. to ft. Dia. in. to ft. Casing height above land surface: 22 in., weight: 160 lbs./ft. Wall thickness or gauge No.

TYPE OF SCREEN OR PERFORATION MATERIAL: 1 Steel 3 Stainless steel 5 Fiberglass 8 RMP (SR) 10 Asbestos-cement 2 Brass 4 Galvanized steel 6 Concrete tile 9 ABS 11 Other (specify) 12 None used (open hole)

SCREEN OR PERFORATION OPENINGS ARE: 1 Continuous slot 3 Mill slot 5 Gauzed wrapped 8 Saw cut 11 None (open hole) 2 Louvered shutter 4 Key punched 6 Wire wrapped 9 Drilled holes 7 Torch cut 10 Other (specify)

SCREEN-PERFORATED INTERVALS: From 40 ft. to 60 ft., From ft. to ft. GRAVEL PACK INTERVALS: From 30 ft. to 60 ft., From ft. to ft.

6 GROUT MATERIAL: 1 Neat cement 2 Cement grout 3 Bentonite 4 Other Grout intervals: From 0 ft. to 25 ft., From ft. to ft., From ft. to ft.

What is the nearest source of possible contamination: 1 Septic tank 4 Lateral lines 7 Pit privy 10 Livestock pens 14 Abandoned water well 2 Sewer lines 5 Cess pool 8 Sewage lagoon 11 Fuel storage 15 Oil well/Gas well 3 Watertight sewer lines 6 Seepage pit 9 Feedyard 12 Fertilizer storage 16 Other (specify below) Farm Pond 13 Insecticide storage 250 feet

Direction from well? How many feet?

FROM	TO	LITHOLOGIC LOG	FROM	TO	PLUGGING INTERVALS
0	8	Surface Clays			
8	17	fine sand			
17	28	Hard yellow Clays			
28	34	med. fine sand			
34	50	med. sand			
50	52	fine sand			
52	55	sluggish sand			
55	60	Hard sand stone & Clays			

7 CONTRACTOR'S OR LANDOWNER'S CERTIFICATION: This water well was (1) constructed, (2) reconstructed, or (3) plugged under my jurisdiction and was completed on (mo/day/year) 5-15-94 and this record is true to the best of my knowledge and belief. Kansas Water Well Contractor's License No. 444 This Water Well Record was completed on (mo/day/yr) 5-15-94 under the business name of Anderson Drilling by (signature) [Signature]