

USE TYPEWRITER OR BALL POINT PEN—PRESS FIRMLY, PRINT CLEARLY.

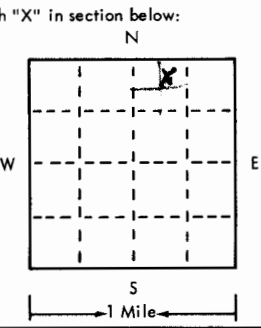
WATER WELL RECORD
KSA 82a-1201-1215

ABA

HILL CITY 5

T R EW sec 1/4 1/4 1/4 No.

Kansas State Dept. Of Health
(Water Well Contractors)
Forbes-Bldg. 740
Topeka, Kansas 66620

1 Location of well:	County GRAHAM	Township name MORLAND	Fraction NENW	Section number 21	Town number 9	Range number 22 W.
Distance and direction from nearest town or city:	7 South e. 4 EAST OF HILL CITY, KS.			3 Owner of well:	MARCELLUS DENNING R. R. HILL CITY, KS. 67642	
Street address of well location if in city:	HILL CITY, KS.					
Locate with "X" in section below:	Sketch map: 			X PASTURE LAND STOCKWELL.		
4 Well depth:	34 ft. Date of completion 9/10/79 Well diameter 9 in.					
5	<input type="checkbox"/> Cable tool <input checked="" type="checkbox"/> Rotary <input type="checkbox"/> Driven <input type="checkbox"/> Dug <input type="checkbox"/> Hollow rod <input type="checkbox"/> Jetted <input type="checkbox"/> Bored <input type="checkbox"/> Reverse rotary					
6 Use:	<input type="checkbox"/> Domestic <input type="checkbox"/> Public supply <input type="checkbox"/> Industry <input type="checkbox"/> Irrigation <input type="checkbox"/> Air conditioning <input type="checkbox"/> Commercial <input type="checkbox"/> Test well <input checked="" type="checkbox"/> STOCK					
7 Casing:	Material PLST Height: above/below Threaded <input type="checkbox"/> Welded <input type="checkbox"/> Surface 18 in. Diam. 5 in. Weight 250 lbs./ft. 5 in. to 34 ft. depth Drive shoe? <input type="checkbox"/> Yes <input type="checkbox"/> No — in. to — ft. depth!					
8 Screen:	Manufacturer JESSIE LOWELL Type PLASTIC Dia. 5" Slot gauge 1/16 Length 10' Set between 34 ft. and 34 ft. Fittings: GRAVEL 1/4 - 5/8" Gravel pack <input checked="" type="checkbox"/> Yes <input type="checkbox"/> No Size range of material Gravel					
9 Static water level:	21 ft. below land surface Date 9/10/79					
10 Pumping level below land surfaces:	NOT DONE — ft. after — hrs. pumping — g.p.m. — ft. after — hrs. pumping — g.p.m. Estimated maximum yield — g.p.m.					
11 Water sample submitted:	<input type="checkbox"/> Yes <input checked="" type="checkbox"/> No Date —					
12 Well head completion:	NO <input type="checkbox"/> Pitless adapter <input type="checkbox"/> Inches above grade					
13 Well grouted?	<input checked="" type="checkbox"/> Yes <input type="checkbox"/> No <input checked="" type="checkbox"/> Neat cement <input type="checkbox"/> Bentonite <input type="checkbox"/> Depth: From 0 ft. to 10 ft.					
14 Nearest source of possible contamination:	NONE SEEN PASTURE ft. — Direction — Type — Well disinfected upon completion? <input type="checkbox"/> Yes <input checked="" type="checkbox"/> No					
15 Pump:	<input checked="" type="checkbox"/> Not installed Manufacturer's name — Model number — HP — Volts — Length of drop pipe — ft. capacity — g.m.p. Type: <input type="checkbox"/> Submersible <input type="checkbox"/> Turbine <input type="checkbox"/> Jet <input type="checkbox"/> Reciprocating <input type="checkbox"/> Centrifugal <input type="checkbox"/> Other					
16 Remarks: elevation	CONCRETE SLAB TO BE INSTALLED AT SURFACE OF GROUND, BY CUSTOMER. 2340					
17 Water well contractor's certification:	This well was drilled under my jurisdiction and this report is true to the best of my knowledge and belief. D.F.L. Drilling Co 303 Business name License No. Address 204368 Hill City, KS Signed [Signature] Date 9/77 Authorized representative					

Forward the white, blue and pink copies to the Kansas State Dept. Of Health.

Form WWC-5

9 2340 21 NENW