


1	LOCATION OF WATER WELL:	Fraction	Section Number	Township Number	Range Number
	County: <u>Graham</u>	<u>NW 1/4 SW 1/4 1/4</u>	<u>35</u>	<u>9</u>	<u>24</u> E10

Distance and direction from nearest town or city street address of well if located within city?
6 miles East, 2 1/2 miles North of St. Peter, Kansas

2	WATER WELL OWNER: <u>Theresa Pfeifer</u>	RR #, St. Address, Box #: City, State, ZIP Code	Board of Agriculture, Division of Water Resources Application Number:
		<u>11000 Albion Drive Thornton, CO 80233</u>	

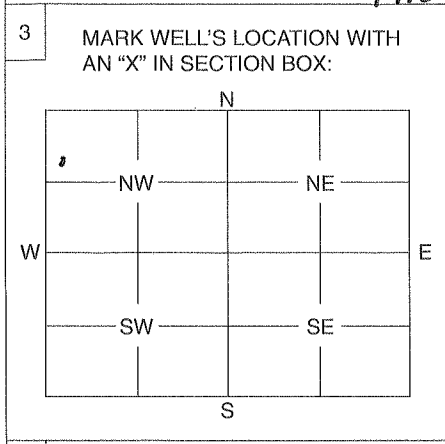

4 DEPTH OF WELL 120 ft.

WELL'S STATIC WATER LEVEL 7.1 ft. from surface

WELL WAS USED AS:

1 Domestic	5 Public Water Supply	9 Dewatering
2 Irrigation	6 Oil Field Water Supply	10 Monitoring Well
3 Feedlot	7 Domestic (Lawn & Garden)	11 Injection Well
4 Industrial	8 Air Conditioning	12 Other <u>Livestock</u>

Was a chemical / bacteriological sample submitted to Department? Yes No X.....
 If yes, mo/day/yr sample was submitted

Water Well Disinfected: Yes X No

5 TYPE OF BLANK CASING USED:

<input checked="" type="radio"/> Steel	3 RMP (SR)	5 Wrought	7 Fiberglass	9 Other (Specify below)
2 PVC	4 ABS	6 Asbestos-Cement	8 Concrete Tile	

Blank casing diameter 5 in. Was casing pulled? Yes X No If yes, how much 3ft.....
 Casing height above or below land surface 36 in. below surface

6 GROUT PLUG MATERIAL: 1 Neat cement 2 Cement grout Bentonite 4 Other

Grout Plug Intervals: From 3 ft. to 20 ft., From ft. to ft., From to ft.

What is the nearest source of possible contamination:

1 Septic tank	6 Seepage pit	11 Fuel storage	16 Other (specify below)
2 Sewer lines	7 Pit privy	12 Fertilizer storage	
3 Watertight sewer lines	8 Sewage lagoon	13 Insecticide storage	
4 Lateral lines	9 Feedyard	14 Abandoned water well	
5 Cess pool	10 Livestock pens	<input checked="" type="radio"/> 15 Oil well/Gas well	

Direction from well? NW How many feet? ~ 3000 feet

FROM	TO	PLUGGING MATERIALS
<u>0</u>	<u>3</u>	<u>Soil</u>
<u>3</u>	<u>20</u>	<u>Bentonite</u>
<u>20</u>	<u>70</u>	<u>Soil</u>
<u>70</u>	<u>120</u>	<u>Sand</u>

7 CONTRACTOR'S OF LANDOWNER'S CERTIFICATION: This water well was plugged under my jurisdiction and was completed on (mo/day/year) November 25, 2011 and this record is true to the best of my knowledge and belief. Kansas Water Well Contractor's License No. Nov. 25, 2011 This Water Well Record was completed on (mo/day/year) Nov. 25, 2011 under the business name of Theresa Pfeifer by (signature) Theresa Pfeifer

INSTRUCTIONS: Use typewriter or ball point pen. Please press firmly and print clearly. Please fill in blanks, underline or circle the correct answers. Send top three copies to Kansas Department of Health and Environment, Bureau of Water, Geology Section, 1000 SW Jackson St., Ste. 420, Topeka, Kansas 66612-1367. Telephone: 785/296-5522. Send one to Water Well Owner and retain one for your records.