

WATER WELL PLUGGING RECORD

FORM WWC-5P

KSA 82a-1212


1	LOCATION OF WATER WELL: Fraction	Section Number	Township Number	Range Number
County: Graham	C 1/4 W1/2 1/4 NE 1/4	3	9	25W

Distance and direction from nearest town or city street address of well if located within city?

Hwy 24 – take road 140 south to Rd L – West 1 Mile – North into

2	WATER WELL OWNER: Grenadine Keith	Board of Agriculture, Division of Water Resources
RR#, St. Address, Box #	508 W Summer	Application Number: 20090346
City, State, ZIP Code	Morland, KS 67650	

3 MARK WELL'S LOCATON WITH AN "X" IN SECTION BOX:

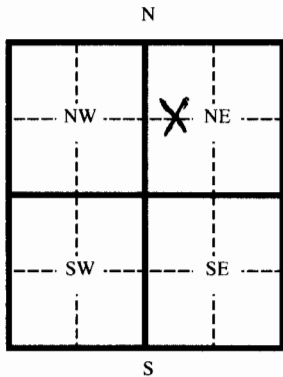

4 DEPTH OF WELL **90** ft.

WELL'S STATIC WATER LEVEL **58** ft.

WELL WAS USED AS:

- | | | |
|--------------|--|--------------------|
| 1 Domestic | 5 Public Water Supply | 9 Dewatering |
| 2 Irrigation | <input checked="" type="checkbox"/> 6 Oil Field Water Supply | 10 Monitoring Well |
| 3 Feedlot | 7 Lawn and Garden (domestic) | 11 Injection Well |
| 4 Industrial | 8 | 12 Other |

Was a chemical/bacteriological sample submitted to Department? Yes ___ No

If yes, mo/day/yr sample was submitted _____

Water Well Disinfected: Yes No _____

5 TYPE OF BLANK CASING USED:

- | | | | | |
|---|------------|-------------------|-----------------|-------------------------|
| 1 Steel | 3 RMP (SR) | 5 Wrought | 7 Fiberglass | 9 Other (specify below) |
| <input checked="" type="checkbox"/> 2 PVC | 4 ABC | 6 Asbestos-Cement | 8 Concrete Tile | |

Blank casing diameter **4.5** in. Was casing pulled? Yes ___ No If yes, how much _____

Casing height above or below land surface **-36** in.

6 GROUT PLUG MATERIAL: 1 Neat cement 2 Cement grout 3 Bentonite 4 Other _____

Grout Plug Intervals From **58** ft. to **55** ft. From **6** ft. to **3** ft. From _____ ft. to _____ ft.

What is the nearest source of possible contamination:

- | | | | |
|--------------------------|-------------------|-------------------------|--------------------------|
| 1 Septic tank | 6 Seepage pit | 11 Fuel storage | 16 Other (specify below) |
| 2 Sewer lines | 7 Pit privy | 12 Fertilizer storage | |
| 3 Watertight sewer lines | 8 Sewage lagoon | 13 Insecticide storage | |
| 4 Lateral lines | 9 Feedyard | 14 Abandoned water well | |
| 5 Cess Pool | 10 Livestock pens | 15 Oil well/ Gas well | |

Direction from well? _____ How many feet? _____

FROM	TO	CODE	PLUGGING MATERIALS
90	58		Chlorintated Sand
58	55		Bentonite
55	6		Native Clay
6	3		Bentonite
3	0		Top Soil

7 CONTRACTOR'S OR LANDOWNER'S CERTIFICATION: This water well was plugged under my jurisdiction and was completed on (mo/day/yr) **09-17-2010** and this record is true to the best of my knowledge and belief. Kansas Water Well Contractor's License No. **554/783** This Water Well Record was completed on (mo/day/yr) **9-21-10** under the business name of **Woofter Pump & Well Inc.** by (signature) _____

INSTRUCTIONS: Please fill in blanks and circle the correct answers. Send three copies to Kansas Department of Health and Environment, Bureau of Water, Topeka, Kansas 66620-0001. Telephone: 785-296-3565. Send one to Water Well Owner and retain one for your records.