

WATER WELL PLUGGING RECORD


FORM WWC-5P

KSA 82a-1212

1	LOCATION OF WATER WELL: Fraction	Section Number	Township Number	Range Number
County: Graham	SE 1/4 SW 1/4 NW 1/4	3	9	25W

Distance and direction from nearest town or city street address of well if located within city?
Hwy 24 – take road 140 south to Rd L – West 1 Mile – North into

2 WATER WELL OWNER: **Logan Keith**
 RR#, St. Address, Box # **508 W Summer** Board of Agriculture, Division of Water Resources
 City, State, ZIP Code : **Morland, KS 67650** Application Number: 20100037

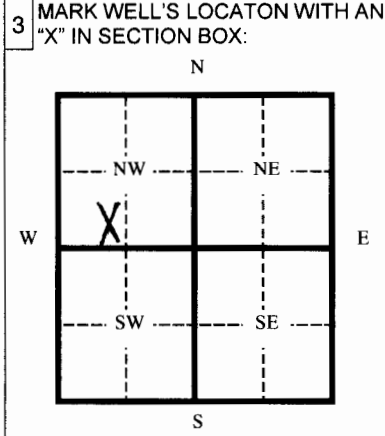

4 DEPTH OF WELL **85** ft.
 WELL'S STATIC WATER LEVEL **52** ft.
 WELL WAS USED AS:
 1 Domestic 5 Public Water Supply 9 Dewatering
 2 Irrigation 6 Oil Field Water Supply 10 Monitoring Well
 3 Feedlot 7 Lawn and Garden (domestic) 11 Injection Well
 4 Industrial 8 12 Other

Was a chemical/bacteriological sample submitted to Department? Yes ___ No **X**
 If yes, mo/day/yr sample was submitted

Water Well Disinfected: Yes **X** No

5 TYPE OF BLANK CASING USED:
 1 Steel 3 RMP (SR) 5 Wrought 7 Fiberglass 9 Other (specify below)
 2 PVC 4 ABC 6 Asbestos-Cement 8 Concrete Tile

Blank casing diameter **4.5** in. Was casing pulled? Yes ___ No **X** If yes, how much

Casing height above or below land surface **-36** in.

6 GROUT PLUG MATERIAL: 1 Neat cement 2 Cement grout 3 Bentonite 4 Other

Grout Plug Intervals From **52** ft. to **49** ft. From **6** ft. to **3** ft. From ft. to ft.

What is the nearest source of possible contamination:
 1 Septic tank 6 Seepage pit 11 Fuel storage 16 Other (specify below)
 2 Sewer lines 7 Pit privy 12 Fertilizer storage

3 Watertight sewer lines 8 Sewage lagoon 13 Insecticide storage

4 Lateral lines 9 Feedyard 14 Abandoned water well

5 Cess Pool 10 Livestock pens 15 Oil well/ Gas well

Direction from well? How many feet?

FROM	TO	CODE	PLUGGING MATERIALS
85	52		Chlorintated Sand
52	49		Bentonite
49	6		Native Clay
6	3		Bentonite
3	0		Top Soil

7 CONTRACTOR'S OR LANDOWNER'S CERTIFICATION: This water well was plugged under my jurisdiction and was completed on (mo/day/yr) **09-17-2010** and this record is true to the best of my knowledge and belief. Kansas Water Well Contractor's License No. **554/783** This Water Well Record was completed on (mo/day/yr) **9-21-10** under the business name of **Woofter Pump & Well Inc.** by (signature) *Jay C. Woofter*

INSTRUCTIONS: Please fill in blanks and circle the correct answers. Send three copies to Kansas Department of Health and Environment, Bureau of Water, Topeka, Kansas 66620-0001. Telephone: 785-296-3565. Send one to Water Well Owner and retain one for your records.