


WATER WELL RECORD Form WWC-5

Division of Water Resources App. No. **47,183**

1 LOCATION OF WATER WELL: Fraction _____ Section Number **20** Township Number **9 S R 26** E W
 County: **Sheridan**
 Street/Rural Address of Well Location; if unknown, distance & direction from nearest town or intersection: If at owner's address, check here
7 miles south & 10 miles east of Hoxie, Ks

Global Positioning System (GPS) information:
 Latitude: _____ (in decimal degrees)
 Longitude: _____ (in decimal degrees)
 Elevation: _____
 Datum: WGS 84, NAD 83, NAD 27
 Collection Method:
 GPS unit (Make/Model: _____)
 Digital Map/Photo, Topographic Map, Land Survey
 Est. Accuracy: <3 m, 3-5 m, 5-15 m, >15 m

2 WATER WELL OWNER: Bradley Simon
 RR#, St. Address, Box # : **7037 S Rd 130 E**
 City, State, ZIP Code : **Hoxie, Ks 67740**

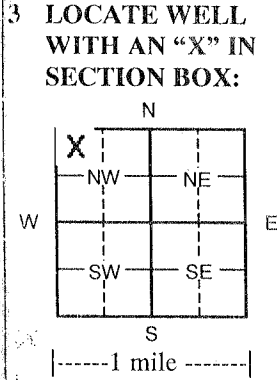

4 DEPTH OF COMPLETED WELL **200** ft.
 Depth(s) Groundwater Encountered (1) _____ ft. (2) _____ ft. (3) _____ ft.
 WELL'S STATIC WATER LEVEL **10.5** ft. below land surface measured on mo/day/yr
 Pump test data: Well water was _____ ft. after _____ hours pumping _____ gpm
 EST. YIELD _____ gpm: Well water was _____ ft. after _____ hours pumping _____ gpm
 WELL WATER TO BE USED AS: Public water supply Geothermal Injection well
 Domestic Feedlot Oil field water supply Dewatering Other (Specify below)
 Irrigation Industrial Domestic-lawn & garden Monitoring well
 Was a chemical/bacteriological sample submitted to Department? Yes No
 If yes, mo/day/yr sample was submitted _____
 Water Well Disinfected? Yes No

5 TYPE OF CASING USED: Steel PVC Other
 CASING JOINTS: Glued Clamped Welded Threaded
 Casing diameter **8** in. to **140** ft., Diameter _____ in. to _____ ft., Diameter _____ in. to _____ ft.
 Casing height above land surface **18** in., Weight **332** lbs./ft. Wall thickness or gauge No. **5.594**

TYPE OF SCREEN OR PERFORATION MATERIAL:
 Steel Stainless Steel PVC Other (Specify) _____
 Brass Galvanized Steel None used (open hole)
SCREEN OR PERFORATION OPENINGS ARE:
 Continuous Slot Mill slot Gauze wrapped Torch cut Drilled holes None (open hole)
 Louvered shutter Key punched Wire wrapped Saw cut Other (specify) _____
SCREEN-PERFORATED INTERVALS: From **140** ft. to **200** ft., From _____ ft. to _____ ft.
GRAVEL PACK INTERVALS: From **20** ft. to **200** ft., From _____ ft. to _____ ft.

6 GROUT MATERIAL: Neat cement Cement grout Bentonite Other
 Grout Intervals From **0** ft. to **20** ft. From _____ ft. to _____ ft. From _____ ft. to _____ ft.
 What is the nearest source of possible contamination:
 Septic tank Lateral lines Pit privy Livestock pens Insecticide storage Other (specify below)
 Sewer lines Cesspool Sewage lagoon Fuel storage Abandoned water well
 Watertight sewer lines Seepage pit Feedyard Fertilizer storage Oil well/gas well **none**
 Direction from well _____ Distance from well _____

FROM	TO	LITHOLOGIC LOG	FROM	TO	LITHO. LOG (cont.) or PLUGGING INTERVALS
0	2	Surface	115	125	Fine to some med sand
2	20	Loess	125	131	Fine to some med sd w/clay lens
20	26	Clay	131	137	Sandy clay, 137 - 140 Fine to some med sd
26	55	Fine to some med sd	140	153	Fine to med sand
55	65	Caliche & clay	153	159	Clay w/a few sand strks
65	73	Clay caliche w/sand strks	159	167	Fine to some med sand
73	100	Fine sand w/caliche strks	167	173	Clay 173 - 184 clay w/a few sd strks
100	107	Caliche & clay	184	191	Sandy clay w/yellow ochre strks
107	112	Fine sand w/caliche strks	191	210	Yellow ochre
112	115	Caliche & clay	210	220	Brown shale

7 CONTRACTOR'S OR LANDOWNER'S CERTIFICATION: This water well was constructed, reconstructed, or plugged under my jurisdiction and was completed on (mo/day/year) **10-05-2011** and this record is true to the best of my knowledge and belief.
 Kansas Water Well Contractor's License No. **554** This Water Well Record was completed on (mo/day/year) **1-16-12**
 under the business name of **Wolf Tex Pump & Well Inc** by (signature) _____

INSTRUCTIONS: Please fill in blanks and check the correct answers. Send three copies (white, blue, pink) to Kansas Department of Health and Environment, Bureau of Water, Geology Section, 1000 SW Jackson St., Suite 420, Topeka, Kansas 66612-1367. Telephone 785-296-5522. Send one to WATER WELL OWNER and retain one for your records. Include fee of \$5.00 for each constructed well. Visit us at <http://www.kdheks.gov/waterwell/index.html>.