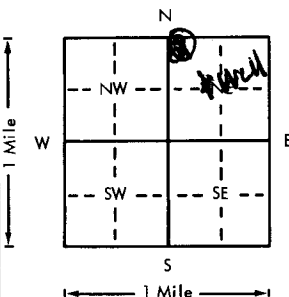
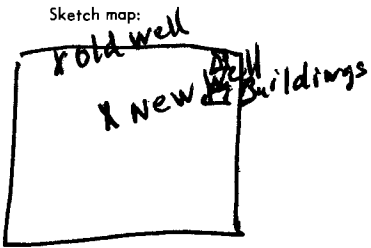


USE TYPEWRITER OR BALL POINT PEN—PRESS FIRMLY, PRINT CLEARLY.

WATER WELL RECORD
KSA 82a-1201-1215

Kansas Department of Health and Environment—Division of Environment
(Water well Contractors)
Topeka, Kansas 66620

1. Location of well: County Sheridan Fraction SE 1/4 NW 1/4 NE 1/4 Section number 22 Township number T 9 S Range number R 26 DRL EW			
2. Distance and direction from nearest town or city: Street address of well location if in city:		3. Owner of well: Lawrence Simon R.R. or street: Morland, Kansas City, state, zip code:	
4. Locate with "X" in section below:  Sketch map: 		6. Bore hole dia. 19 in. Completion date _____ Well depth 200 ft. 7/23/76	
5. Type and color of material		7. <input type="checkbox"/> Cable tool <input checked="" type="checkbox"/> Rotary <input type="checkbox"/> Driven <input type="checkbox"/> Dug <input type="checkbox"/> Hollow rod <input type="checkbox"/> Jetted <input type="checkbox"/> Bored <input checked="" type="checkbox"/> Reverse rotary	
silt + clay		8. Use: <input type="checkbox"/> Domestic <input type="checkbox"/> Public supply <input type="checkbox"/> Industry <input checked="" type="checkbox"/> Irrigation <input type="checkbox"/> Air conditioning <input type="checkbox"/> Stock <input type="checkbox"/> Lawn <input type="checkbox"/> Oil field water <input type="checkbox"/> Other	
clay + sandstone		9. Casing: Material CEAS Height: above or below Threaded _____ Welded clamp Surface 12 in. RMP _____ PVC _____ Weight _____ lbs./ft. Dia. 12 in. to 200 ft. depth Wall Thickness: inches or Dia. _____ in. to _____ ft. depth gage No. _____	
clay		10. Screen: Manufacturer's name _____ Johnson Well casing Type: cement asbestos , 12 in. Slot/gauze 3/4 Length 13 ft. Set between 148 ft. and 200 ft. _____ ft. and _____ ft.	
clay layer 145' sand + gravel		11. Gravel pack? <input checked="" type="checkbox"/> Size range of material 1 down	
yellow clay		12. Static water level: _____ mo./day/yr. 1 ft. below land surface Date 7/23/76	
(Use a second sheet if needed)		13. Pumping level below land surfaces: _____ ft. after _____ hrs. pumping _____ g.p.m. _____ ft. after _____ hrs. pumping _____ g.p.m. Estimated maximum yield 450 g.p.m.	
		14. Water sample submitted: _____ mo./day/yr. Yes <input type="checkbox"/> No <input checked="" type="checkbox"/> Date _____	
		15. Well head completion: <input type="checkbox"/> Pitless adapter _____ inches above grade	
		16. Well grouted? <input checked="" type="checkbox"/> cement slab With: <input type="checkbox"/> Neat cement <input type="checkbox"/> Bentonite <input checked="" type="checkbox"/> Concrete Depth: From 0 ft. to 5 ft.	
		17. Nearest source of possible contamination: ft. _____ Direction _____ Type _____ Well disinfected upon completion? _____ Yes _____ No	
		18. Pump: Manufacturer's name <input checked="" type="checkbox"/> Not installed Model number _____ HP _____ Volts _____ Length of drop pipe _____ ft. capacity _____ g.p.m. Type: <input type="checkbox"/> Submersible <input type="checkbox"/> Turbine <input type="checkbox"/> Jet <input type="checkbox"/> Reciprocating <input type="checkbox"/> Centrifugal <input type="checkbox"/> Other	
18. Elevation:	19. Remarks:	20. Water well contractor's certification: This well was drilled under my jurisdiction and this report is true to the best of my knowledge and belief. Aqua Well Drilling 281 Business name License No. Address Gove, Ks. 67736 Signed M. J. Jutte Date 6-26-77 Authorized representative	
Topography: <input type="checkbox"/> Hill <input type="checkbox"/> Slope <input checked="" type="checkbox"/> Upland <input type="checkbox"/> Valley			

Forward the white, blue and pink copies to the Department of Health and Environment

Form WWC-5