


1 LOCATION OF WATER WELL: Fraction Section Number Township Number Range Number
 County: Sheridan SE 1/4 SE 1/4 NW 1/4 23 T 9 S R 26 EW

Distance and direction from nearest town or city street address of well if located within city?
6 south and 13 east of Hoxie, Ks.

2 WATER WELL OWNER: Oscar Borger Red Tiger Drilling
 RR#, St. Address, Box #: 125 N. Market Suite 1720 Board of Agriculture, Division of Water Resources
 City, State, ZIP Code: Hoxie, Ks. Wichita, Ks. 67202-1793 Application Number: 910099

3 LOCATE WELL'S LOCATION WITH AN "X" IN SECTION BOX:

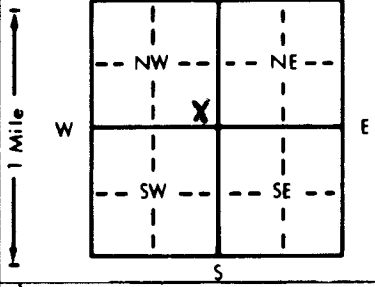

4 DEPTH OF COMPLETED WELL: 166 ft. ELEVATION:
 Depth(s) Groundwater Encountered 1. ft. 2. ft. 3. ft.
 WELL'S STATIC WATER LEVEL: 80 ft. below land surface measured on mo/day/yr
 Pump test data: Well water was ft. after hours pumping gpm
 Est. Yield gpm: Well water was ft. after hours pumping gpm
 Bore Hole Diameter: 8 in. to 166 ft., and in. to ft.
 WELL WATER TO BE USED AS:
 5 Public water supply 8 Air conditioning 11 Injection well
 1 Domestic 3 Feedlot 6 Oil field water supply 9 Dewatering 12 Other (Specify below)
 2 Irrigation 4 Industrial 7 Lawn and garden only 10 Monitoring well
 Was a chemical/bacteriological sample submitted to Department? Yes. No. X If yes, mo/day/yr sample was sub-
 mitted Water Well Disinfected? Yes No X

5 TYPE OF BLANK CASING USED:
 1 Steel 3 RMP (SR) 5 Wrought iron 8 Concrete tile CASING JOINTS: Glued X Clamped
 2 PVC 4 ABS 6 Asbestos-Cement 9 Other (specify below) Welded
 7 Fiberglass Threaded

Blank casing diameter 4.5 in. to 126 ft., Dia. in. to ft., Dia. in. to ft.
 Casing height above land surface: 18 in., weight 2.38 lbs./ft. Wall thickness or gauge No. 248

TYPE OF SCREEN OR PERFORATION MATERIAL:
 1 Steel 3 Stainless steel 5 Fiberglass 7 PVC 10 Asbestos-cement
 2 Brass 4 Galvanized steel 6 Concrete tile 8 RMP (SR) 11 Other (specify)
 12 None used (open hole)

SCREEN OR PERFORATION OPENINGS ARE:
 1 Continuous slot 3 Mill slot 5 Gauzed wrapped 8 Saw cut 11 None (open hole)
 2 Louvered shutter 4 Key punched 6 Wire wrapped 9 Drilled holes
 7 Torch cut 10 Other (specify)

SCREEN-PERFORATED INTERVALS: From 126 ft. to 166 ft., From ft. to ft.
 From ft. to ft., From ft. to ft.
 GRAVEL PACK INTERVALS: From 20 ft. to 166 ft., From ft. to ft.
 From ft. to ft., From ft. to ft.

6 GROUT MATERIAL: 1 Neat cement 2 Cement grout 3 Bentonite 4 Other
 Grout intervals: From ft. to ft., From ft. to ft., From ft. to ft.

What is the nearest source of possible contamination:
 1 Septic tank 4 Lateral lines 7 Pit privy 10 Livestock pens 14 Abandoned water well
 2 Sewer lines 5 Cess pool 8 Sewage lagoon 11 Fuel storage 15 Oil well/Gas well
 3 Watertight sewer lines 6 Seepage pit 9 Feedyard 12 Fertilizer storage 16 Other (specify below)
 13 Insecticide storage

Direction from well? West How many feet? 150

FROM	TO	LITHOLOGIC LOG	FROM	TO	PLUGGING INTERVALS
0	3	Surface	113	117	Sandy clay
3	29	Clay	117	130	Med. sand
29	33	Med. sand	130	131	Caliche
33	38	Clay	131	132	Med. sand
38	44	Fine sand	132	137	Caliche with sand streak
44	47	Caliche & clay	137	139	Clay
47	51	Fine sand	139	162	Med. sand
51	70	Caliche & clay	162	166	Ochre & shale
70	75	Fine sand			
75	90	Caliche & clay			
90	95	Fine sand			
95	110	Clay, sand streak			
110	112	Fine sand			
112	113	Clay			

7 CONTRACTOR'S OR LANDOWNER'S CERTIFICATION: This water well was (1) constructed, (2) reconstructed, or (3) plugged under my jurisdiction and was completed on (mo/day/year) 2-19-91 and this record is true to the best of my knowledge and belief. Kansas Water Well Contractor's License No. 394 This Water Well Record was completed on (mo/day/yr) 2-20-91 under the business name of WOOPPER PUMP & WELL by (signature) Walter Woopler

INSTRUCTIONS: Use typewriter or ball point pen. PLEASE PRESS FIRMLY and PRINT clearly. Please fill in blanks, underline or circle the correct answers. Send top three copies to Kansas Department of Health and Environment, Bureau of Water, Topeka, Kansas 66620-7320. Telephone: 913-296-5545. Send one to WATER WELL OWNER and retain one for your records.

OFFICE USE ONLY
T
R
EW
SEC.