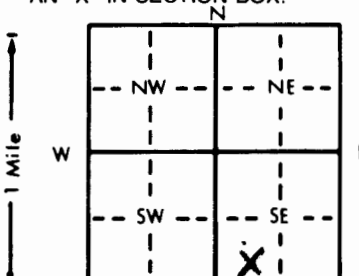


1] LOCATION OF WATER WELL: Fraction S 1/2 1/4 SW 1/4 SE 1/4 Section Number 24 Township Number T 9 S Range Number R 26 E/W  
 County: Sheridan

Distance and direction from nearest town or city street address of well if located within city?  
6 miles South, 15 miles east, 1 mile south, 1/2 mile west of Hoxie

2] WATER WELL OWNER: Perry Corke Castle Resources  
 RR#, St. Address, Box #: 410 McKinney 1200 E.27 Suite C Board of Agriculture, Division of Water Resources  
 City, State, ZIP Code: Quinter, Ks. 67752 Hays, Ks. 67601-2120 Application Number: 920376

3] LOCATE WELL'S LOCATION WITH AN "X" IN SECTION BOX:  
  
 4] DEPTH OF COMPLETED WELL: 187 ft. ELEVATION: ..... ft.  
 Depth(s) Groundwater Encountered 1. .... ft. 2. .... ft. 3. .... ft.  
 WELL'S STATIC WATER LEVEL 120 ft. below land surface measured on mo/day/yr  
 Pump test data: Well water was ..... ft. after ..... hours pumping ..... gpm  
 Est. Yield ..... gpm: Well water was ..... ft. after ..... hours pumping ..... gpm  
 Bore Hole Diameter ..... in. to ..... ft., and ..... in. to ..... ft.  
 WELL WATER TO BE USED AS: 5 Public water supply 8 Air conditioning 11 Injection well  
 1 Domestic 3 Feedlot 6 Oil field water supply 9 Dewatering 12 Other (Specify below)  
 2 Irrigation 4 Industrial 7 Lawn and garden only 10 Monitoring well  
 Was a chemical/bacteriological sample submitted to Department? Yes.....No. X.....; If yes, mo/day/yr sample was submitted  
 Water Well Disinfected? Yes No X

5] TYPE OF BLANK CASING USED: 5 Wrought iron 8 Concrete tile CASING JOINTS: Glued X Clamped .....  
 1 Steel 3 RMP (SR) 6 Asbestos-Cement 9 Other (specify below) Welded .....  
 2 PVC 4 ABS 7 Fiberglass Threaded .....  
 Blank casing diameter 4.5 in. to 147 ft. Dia ..... in. to ..... ft. Dia ..... in. to ..... ft.  
 Casing height above land surface 18 in., weight 2.38 lbs./ft. Wall thickness or gauge No. 248  
 TYPE OF SCREEN OR PERFORATION MATERIAL: 7 PVC 10 Asbestos-cement  
 1 Steel 3 Stainless steel 5 Fiberglass 8 RMP (SR) 11 Other (specify) .....  
 2 Brass 4 Galvanized steel 6 Concrete tile 9 ABS 12 None used (open hole)  
 SCREEN OR PERFORATION OPENINGS ARE: 5 Gauzed wrapped 8 Saw cut 11 None (open hole)  
 1 Continuous slot 3 Mill slot 6 Wire wrapped 9 Drilled holes  
 2 Louvered shutter 4 Key punched 7 Torch cut 10 Other (specify) .....  
 SCREEN-PERFORATED INTERVALS: From 147 ft. to 187 ft. From ..... ft. to ..... ft.  
 From ..... ft. to ..... ft. From ..... ft. to ..... ft.  
 GRAVEL PACK INTERVALS: From 20 ft. to 187 ft. From ..... ft. to ..... ft.  
 From ..... ft. to ..... ft. From ..... ft. to ..... ft.

6] GROUT MATERIAL: 1 Neat cement 2 Cement grout 3 Bentonite 4 Other .....  
 Grout Intervals: From 0 ft. to 20 ft. From ..... ft. to ..... ft. From ..... ft. to ..... ft.  
 What is the nearest source of possible contamination: NONE  
 1 Septic tank 4 Lateral lines 7 Pit privy 10 Livestock pens 14 Abandoned water well  
 2 Sewer lines 5 Cess pool 8 Sewage lagoon 11 Fuel storage 15 Oil well/Gas well  
 3 Watertight sewer lines 6 Seepage pit 9 Feedyard 12 Fertilizer storage 16 Other (specify below)  
 13 Insecticide storage  
 Direction from well? ..... How many feet? .....

FROM	TO	LITHOLOGIC LOG	FROM	TO	PLUGGING INTERVALS
0	3	Surface	83	85	Caliche
3	21	Clay & Caliche Strks.	85	90	Med. Sand-Tight Clay Strks.
21	26	Fine Sand-Cemented Strks.	90	101	Caliche-Clay & Cemented Strks
26	29	Cemented Sand	101	112	Clay-Sandy
29	32	Caliche	112	120	Med. Sand/Clay Strks.
32	42	Fine Sand & Sandy Clay	120	135	Clay & Caliche
42	47	Cemented Sand	135	147	Med. Sand
47	51	Sand-Med.	147	157	Caliche Clay-Fine Clay Layers
51	57	Sandy Tan Clay	157	174	Med. Sand-Semi Tight.
57	67	Sand	174	175	Caliche
67	70	Caliche	175	187	Tight Fine to Med. Sand
70	76	Med. Sand/Caliche Strks.			
76	79	Clay			
79	79.5	Rock Layer			
79.5	83	Clay			

7] CONTRACTOR'S OR LANDOWNER'S CERTIFICATION: This water well was (1) constructed, (2) reconstructed, or (3) plugged under my jurisdiction and was completed on (mo/day/year) 10-27-92 and this record is true to the best of my knowledge and belief. Kansas Water Well Contractor's License No. 554 This Water Well Record was completed on (mo/day/yr) 10-30-92 under the business name of WOOFTER PUMP & WELL, INC. by (signature) Jay C. Woofter

OFFICE USE ONLY  
T  
R  
EW  
SEC.  
1/4  
1/4  
1/4