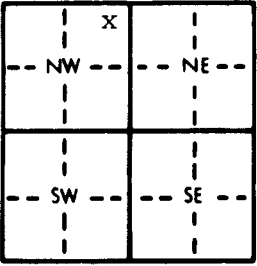


1 LOCATION OF WATER WELL: Fraction NE 1/4 NE 1/4 NW 1/4 Section Number 24 Township Number T 9 S Range Number R 26 W EW
 County: Sheridan
 Distance and direction from nearest town or city street address of well if located within city?
N/A - LOCATION CONFIRMED BY GMD #4

2 WATER WELL OWNER: Ray G. & Rena F. Corke
 RR#, St. Address, Box # : 401 McKinney Board of Agriculture, Division of Water Resources
 City, State, ZIP Code : Quinter, KS 67752 Application Number:

3 LOCATE WELL'S LOCATION WITH AN "X" IN SECTION BOX:

 4 DEPTH OF COMPLETED WELL: 14.0 *approx* ft. ELEVATION:
 Depth(s) Groundwater Encountered 1. 14.0 ft. 2. dry ft. 3. dry ft.
 WELL'S STATIC WATER LEVEL dry ft. below land surface measured on mo/day/yr
 WELL WATER TO BE USED AS:
 5 Public water supply 8 Air conditioning 11 Injection well
 X1 Domestic 3 Feedlot 6 Oil field water supply 9 Dewatering 12 Other (Specify below)
 2 Irrigation 4 Industrial 7 Lawn and garden only 10 Monitoring well
 Was a chemical/bacteriological sample submitted to Department? Yes.....No.....; If yes, mo/day/yr sample was submitted
 Water Well Disinfected? Yes No


5 TYPE OF BLANK CASING USED:
 Xi Steel 3 RMP (SR) 5 Wrought iron 8 Concrete tile CASING JOINTS: Glued Clamped
 2 PVC 4 ABS 6 Asbestos-Cement 9 Other (specify below) Welded
 7 Fiberglass Threaded
 Blank casing diameter 5 in. to dry ft., Dia dry in. to dry ft., Dia dry in. to dry ft.
 Casing height above land surface 0 in., weight dry lbs./ft. Wall thickness or gauge No. dry
 TYPE OF SCREEN OR PERFORATION MATERIAL:
 1 Steel 3 Stainless steel 5 Fiberglass 8 RMP (SR) 10 Asbestos-cement
 2 Brass 4 Galvanized steel 6 Concrete tile 9 ABS 12 None used (open hole)
 SCREEN OR PERFORATION OPENINGS ARE:
 1 Continuous slot 3 Mill slot 5 Gauzed wrapped 8 Saw cut 11 None (open hole)
 2 Louvered shutter 4 Key punched 6 Wire wrapped 9 Drilled holes
 7 Torch cut 10 Other (specify)
 SCREEN-PERFORATED INTERVALS: From ft. to ft., From ft. to ft.
 From ft. to ft., From ft. to ft.
 GRAVEL PACK INTERVALS: From ft. to ft., From ft. to ft.
 From ft. to ft., From ft. to ft.

6 GROUT MATERIAL: 1 Neat cement 2 Cement grout 3 Bentonite 4 Other
 Grout Intervals: From 4 ft. to 7 ft., From ft. to ft., From ft. to ft.
 What is the nearest source of possible contamination:
 1 Septic tank 4 Lateral lines 7 Pit privy 10 Livestock pens 14 Abandoned water well
 2 Sewer lines 5 Cess pool 8 Sewage lagoon 11 Fuel storage 15 Oil well/Gas well
 3 Watertight sewer lines 6 Seepage pit 9 Feedyard 12 Fertilizer storage 16 Other (specify below)
 13 Insecticide storage
 Direction from well? How many feet?

FROM	TO	LITHOLOGIC LOG	FROM	TO	PLUGGING INTERVALS
	ENTER				
			14.0?	7	dirt
			7	4	cement
		PLUGGING			
					(top of casing is in 4 ft. deep pit)
		INFORMATION			
		AT			
		RIGHT			

7 CONTRACTOR'S OR LANDOWNER'S CERTIFICATION: This water well was (1) constructed, (2) reconstructed, or (3) plugged under my jurisdiction and was completed on (mo/day/year) 2-27-90 and this record is true to the best of my knowledge and belief. Kansas Water Well Contractor's License No. 2-27-90 This Water Well Record was completed on (mo/day/yr) 2-27-90 under the business name of Ray Corke by (signature) Ray Corke

OFFICE USE ONLY

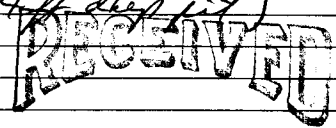

MAR 05 1990

DIVISION OF ENVIRONMENT