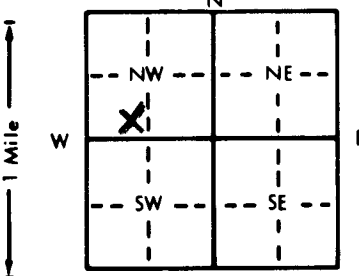


1 LOCATION OF WATER WELL: Fraction SE 1/4 SW 1/4 NW 1/4 Section Number 10 Township Number T 9 S Range Number R 28 **EW**
 County: Sheridan

Distance and direction from nearest town or city street address of well if located within city?
5 Miles South of Hoxie

2 WATER WELL OWNER: Sheridan Co. Landfill Board of Agriculture, Division of Water Resources
 RR#, St. Address, Box # : _____ Application Number: _____
 City, State, ZIP Code : Hoxie, Ks. 67740 #2

3 LOCATE WELL'S LOCATION WITH AN "X" IN SECTION BOX:

 4 DEPTH OF COMPLETED WELL. 108 ft. ELEVATION: _____
 Depth(s) Groundwater Encountered 1. _____ ft. 2. _____ ft. 3. _____ ft.
 WELL'S STATIC WATER LEVEL . . . 64.82 ft. below land surface measured on mo/day/yr _____
 Pump test data: Well water was _____ ft. after _____ hours pumping _____ gpm
 Est. Yield _____ gpm: Well water was _____ ft. after _____ hours pumping _____ gpm
 Bore Hole Diameterin. to 108ft., andin. toft.
 WELL WATER TO BE USED AS: 5 Public water supply 8 Air conditioning 11 Injection well
 1 Domestic 3 Feedlot 6 Oil field water supply 9 Dewatering 12 Other (Specify below)
 2 Irrigation 4 Industrial 7 Lawn and garden only 10 Monitoring well _____
 Was a chemical/bacteriological sample submitted to Department? Yes _____ No X _____; If yes, mo/day/yr sample was submitted _____
 Water Well Disinfected? Yes _____ No X _____

5 TYPE OF BLANK CASING USED: 5 Wrought iron 8 Concrete tile CASING JOINTS: Glued _____ Clamped _____
 1 Steel 3 RMP (SR) 6 Asbestos-Cement 9 Other (specify below) Welded _____
 2 PVC 4 ABS 7 Fiberglass _____ Threaded X _____
 Blank casing diameter2 in. to 78ft., Diain. toft., Diain. toft.
 Casing height above land surfacein., weight7.16lbs./ft. Wall thickness or gauge No. 1.54
 TYPE OF SCREEN OR PERFORATION MATERIAL: 7 PVC 10 Asbestos-cement
 1 Steel 3 Stainless steel 5 Fiberglass 8 RMP (SR) 11 Other (specify) _____
 2 Brass 4 Galvanized steel 6 Concrete tile 9 ABS 12 None used (open hole)
 SCREEN OR PERFORATION OPENINGS ARE: 5 Gauzed wrapped 8 Saw cut 11 None (open hole)
 1 Continuous slot 3 Mill slot 6 Wire wrapped 9 Drilled holes
 2 Louvered shutter 4 Key punched 7 Torch cut 10 Other (specify) _____
 SCREEN-PERFORATED INTERVALS: From78ft. to 108ft., Fromft. toft.
 Fromft. toft., Fromft. toft.
 GRAVEL PACK INTERVALS: From65ft. to 108ft., Fromft. toft.
 Fromft. toft., Fromft. toft.

6 GROUT MATERIAL: 1 Neat cement 2 Cement grout 3 Bentonite 4 Other _____
 Grout Intervals: From 0ft. to 65ft., Fromft. toft., Fromft. toft.
 What is the nearest source of possible contamination:
 1 Septic tank 4 Lateral lines 7 Pit privy 10 Livestock pens 14 Abandoned water well
 2 Sewer lines 5 Cess pool 8 Sewage lagoon 11 Fuel storage 15 Oil well/Gas well
 3 Watertight sewer lines 6 Seepage pit 9 Feedyard 12 Fertilizer storage 16 Other (specify below)
 13 Insecticide storage Landfill _____
 Direction from well? _____ How many feet? _____

FROM	TO	LITHOLOGIC LOG	FROM	TO	PLUGGING INTERVALS
0	1	Surface	101	107	Caliche, Cemented Sand & Sand Strks.
1	9	Sandy Clay			
9	15	Caliche w/Clay Strks.	107	108	Sand
15	22	Sand & Gravel			
22	40	Sandy Clay & Caliche w/Some Sand Strks.			
40	52	Fine Sand			
52	61	Clay & Caliche			
61	64	Fine Sand			
64	65	Clay			
65	72	Sand			
72	81	Sandy Clay w/Sand & Caliche Strks.			
81	85	Sand			
85	88	Clay			
88	90.5	Sand			
90.5	101	Sand			

7 CONTRACTOR'S OR LANDOWNER'S CERTIFICATION: This water well was (1) constructed, (2) reconstructed, or (3) plugged under my jurisdiction and was completed on (mo/day/year) 9-1-93 and this record is true to the best of my knowledge and belief. Kansas Water Well Contractor's License No. 554 This Water Well Record was completed on (mo/day/yr) 9-2-93 under the business name of Woofter Pump & Well, Inc. by (signature) [Signature]

OFFICE USE ONLY
T
R
EW
SEC.
1/4
1/4
1/4