


1 LOCATION OF WATER WELL: Fraction NW 1/4 SE 1/4 NE 1/4 Section Number 18 Township Number T 9 S Range Number R 28 EW

Distance and direction from nearest town or city street address of well if located within city?
6 miles south 2 west & 1/4 north of Hoxie, Ks. 67740

2 WATER WELL OWNER: Kenneth Clark
RR#, St. Address, Box # : 323 N. Pomeroy Board of Agriculture, Division of Water Resources
City, State, ZIP Code : Hill City, Ks. 67642 Application Number:

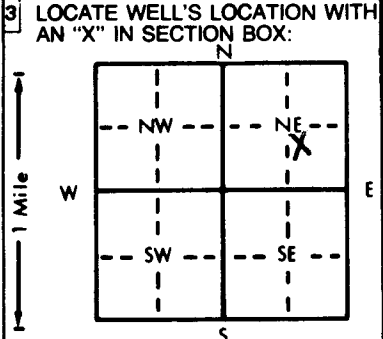

4 DEPTH OF COMPLETED WELL... 220... ft. ELEVATION: ...
Depth(s) Groundwater Encountered 1. ft. 2. ft. 3. ft.
WELL'S STATIC WATER LEVEL ft. below land surface measured on mo/day/yr
Pump test data: Well water was ft. after hours pumping gpm
Est. Yield gpm: Well water was ft. after hours pumping gpm
Bore Hole Diameter.. 8 in. to 220 ft., and in. to ft.
WELL WATER TO BE USED AS: 5 Public water supply 8 Air conditioning 11 Injection well
1 Domestic 3 Feedlot 6 Oil field water supply 9 Dewatering 12 Other (Specify below)
2 Irrigation 4 Industrial 7 Lawn and garden only 10 Monitoring well
Was a chemical/bacteriological sample submitted to Department? Yes.....No...X.....; If yes, mo/day/yr sample was submitted
Water Well Disinfected? Yes No X

5 TYPE OF BLANK CASING USED: 5 Wrought iron 8 Concrete tile CASING JOINTS: Glued .X. Clamped
1 Steel 3 RMP (SR) 6 Asbestos-Cement 9 Other (specify below) Welded
2 PVC 4 ABS 7 Fiberglass Threaded
Blank casing diameter ... 4.5 in. to ... 200 ft., Dia in. to ft., Dia in. to ft.
Casing height above land surface 18 in., weight 2.38 lbs./ft. Wall thickness or gauge No. 248
TYPE OF SCREEN OR PERFORATION MATERIAL: 7 PVC 10 Asbestos-cement
1 Steel 3 Stainless steel 5 Fiberglass 8 RMP (SR) 11 Other (specify)
2 Brass 4 Galvanized steel 6 Concrete tile 9 ABS 12 None used (open hole)
SCREEN OR PERFORATION OPENINGS ARE: 5 Gauzed wrapped 8 Saw cut 11 None (open hole)
1 Continuous slot 3 Mill slot 6 Wire wrapped 9 Drilled holes
2 Louvered shutter 4 Key punched 7 Torch cut 10 Other (specify)
SCREEN-PERFORATED INTERVALS: From ... 200 ft. to ... 220 ft., From ft. to ft.
From ft. to ft., From ft. to ft.
GRAVEL PACK INTERVALS: From ... 20 ft. to ... 220 ft., From ft. to ft.
From ft. to ft., From ft. to ft.

6 GROUT MATERIAL: 1 Neat cement 2 Cement grout 3 Bentonite 4 Other
Grout Intervals: From ... 0 ft. to ... 20 ft., From ft. to ft., From ft. to ft.
What is the nearest source of possible contamination: NONE 10 Livestock pens 14 Abandoned water well
1 Septic tank 4 Lateral lines 7 Pit privy 11 Fuel storage 15 Oil well/Gas well
2 Sewer lines 5 Cess pool 8 Sewage lagoon 12 Fertilizer storage 16 Other (specify below)
3 Watertight sewer lines 6 Seepage pit 9 Feedyard 13 Insecticide storage

Direction from well? How many feet?

| FROM | TO | LITHOLOGIC LOG | FROM | TO | PLUGGING INTERVALS |
|------|-----|-------------------|------|-----|-------------------------------|
| 0 | 3 | Surface | 147 | 156 | Clay |
| 3 | 37 | Clay & caliche | 156 | 160 | Fine sand |
| 37 | 48 | Sand (fine) | 160 | 161 | Clay |
| 48 | 52 | Clay | 161 | 171 | Med. sand |
| 52 | 58 | Med. sand | 171 | 185 | Clay, calikche & sand sstrks. |
| 58 | 60 | Clay | 185 | 189 | Med. sand |
| 60 | 77 | Fine sand | 189 | 209 | Clay |
| 77 | 104 | Clay | 209 | 216 | Med. sand |
| 104 | 115 | Fine to med. sand | 216 | 218 | Ochre |
| 115 | 130 | Clay & caliche | 218 | 220 | Shale |
| 130 | 132 | Med. sand | | | |
| 132 | 138 | Fine sand | | | |
| 138 | 141 | Clay | | | |
| 141 | 147 | Med. sand | | | |

7 CONTRACTOR'S OR LANDOWNER'S CERTIFICATION: This water well was (1) constructed, (2) reconstructed, or (3) plugged under my jurisdiction and was completed on (mo/day/year) 8-12-91 and this record is true to the best of my knowledge and belief. Kansas Water Well Contractor's License No. 394 This Water Well Record was completed on (mo/day/yr) 8-14-91 under the business name of WOOFER PUMP & WELL by (signature) *Walter W. Woffter*

INSTRUCTIONS: Use typewriter or ball point pen. PLEASE PRESS FIRMLY and PRINT clearly. Please fill in blanks, underline or circle the correct answers. Send top three copies to Kansas Department of Health and Environment, Bureau of Water, Topeka, Kansas 66620-0001. Telephone: 913-296-5545. Send one to WATER WELL OWNER and retain one for your records.

OFFICE USE ONLY
T
R
EW
SEC.
1/4
1/4
1/4